

Bridge 32-7.29  
(marked 0.00)

Sta.

159+00 found PK

156+00

155+25 point where ditch base line crosses E

155+03.5 N. edge Brq.

154+59.5 S. edge Brq.

~~154+50~~ not used  
point where ditch base line crosses E

799.85'  
meas. twice

148+00


146+00 found PK

Nichols  
J. Buchenroth  
Grites

Thompson

2 August 1967  
pm hot 90°

47

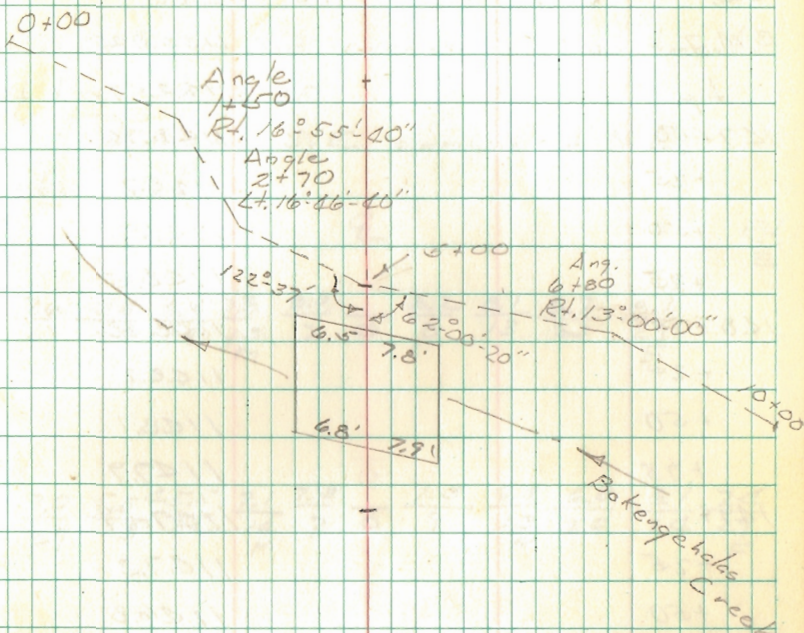

INDEXED ON MAP

4360