


FOPP SURVEY

HARRISON TWP., LOGAN CO., OHIO

SECTION 25, TOWN 2, RANGE 15 - 1" = 100'

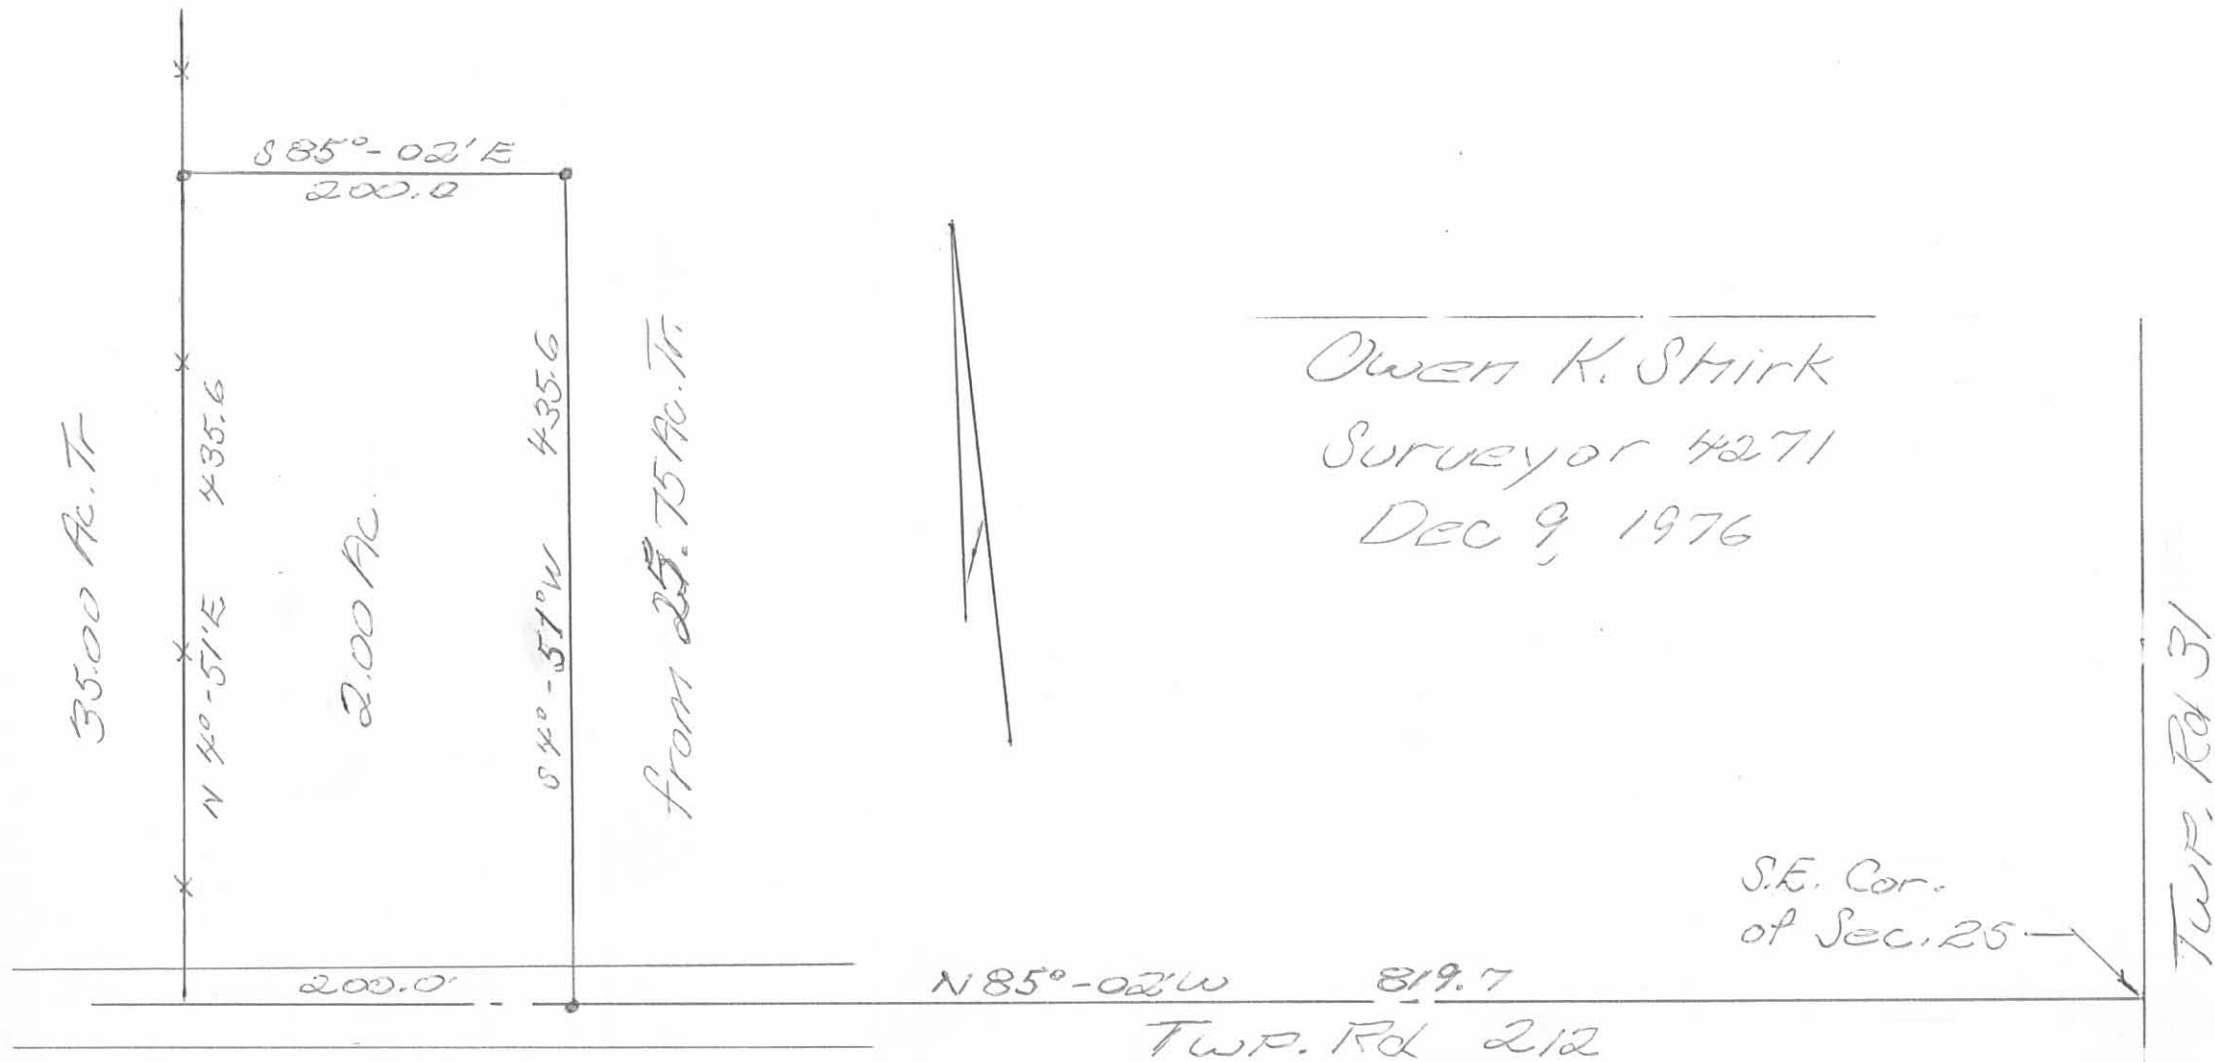

Owen K. Stirk
Surveyor 4271
Dec 9, 1976

INDEXED ON MAP
5974 1P