

PROFESSIONAL SURVEYOR'S AFFIDAVIT

STATE OF OHIO,  
COUNTY OF LOGAN, ss:

Daniel E. Gilbert, being first duly sworn, deposes and says that he is a Registered Professional Surveyor under the laws of the State of Ohio, being Professional Surveyor No. 5402 and that he is making this affidavit for the purpose of correcting the description to a certain piece of real estate situated in the Township of Harrison, County of Logan, State of Ohio, presently owned by Robert H. Clagg by virtue of a Warranty Deed recorded in Deed Volume No. 298 Page 488 of the Logan County Record of Deeds.

The corrected description being as follows with corrections underlined:

The following described real estate situated in the County of Logan, State of Ohio, Harrison Township and being a part of Section No. 7, Town 2, Range 15 of the Between the Miami Rivers Survey and more particularly described as follows:

Beginning at a spike in the center of U. S. Route 33 at the northeast corner of William B. McCormick's 22.59 acre tract as shown in Logan County Engineer's Field Book No. 521 page 62;

Thence with said McCormick's north line, N. 85°04' W. 916.00 feet to a concrete post in the east line of the C.C.C. and St. L. R.R.;

Thence with said east right of way line, being a curve to the right, a chord bearing N. 16°28' W. 394.40 feet to a square concrete post;

Thence S. 85°04' E. 740.40 feet to a spike in the center of U.S. Route 33;

Thence with the center line, S. 36°04' E. 487.00 feet to the place of beginning.

Containing 7.00 acres, more or less.

Part of Parcel # 09-076-00-00-010-000

This affidavit is made in compliance with Revised Code of Ohio Sec. 5301.252 and particularly to show an affidavit of a professional surveyor to reconcile conflicts and ambiguities in descriptions of land in recorded instruments as stated in paragraph B(5) of Section 5301.252. Under Sec. 5301.252(C) the County Recorder shall receive and cause such affidavit to be recorded as deeds are recorded.

DESCRIPTION CHECKED  
LOGAN CO. ENGINEER  
JMA 7-16-04



*Daniel E. Gilbert*  
Daniel E. Gilbert  
Professional Surveyor No. 5402

INDEXED ON MAP  
6927 10-1

STATE OF OHIO,  
LOGAN COUNTY, ss:

BE IT REMEMBERED, that on this 16<sup>th</sup> day of July, 2004, before me, the subscriber, a Notary Public in and for said County and State, personally came the above named Daniel E. Gilbert, the maker of the foregoing Affidavit, and acknowledged the signing of the same to be his voluntary act and deed, for the uses and purposes therein mentioned.

IN TESTIMONY WHEREOF, I have hereunto subscribed my name and affixed my official seal, on the day and year last aforesaid.



*John B. Kelly*  
\_\_\_\_\_  
Notary Public  
JOHN B. KELLY  
NOTARY PUBLIC STATE OF OHIO  
LIFETIME COMMISSION  
Attorney At Law


RECORDER:

Please cross reference to Deed Volume 298 Page 488 in the Abstract of the Deed Records of Logan County, Ohio.

TRANSFER NOT NECESSARY  
LOGAN COUNTY AUDITOR

7-16-04 *tw*

INDEXED ON MAP  
6927 10-2

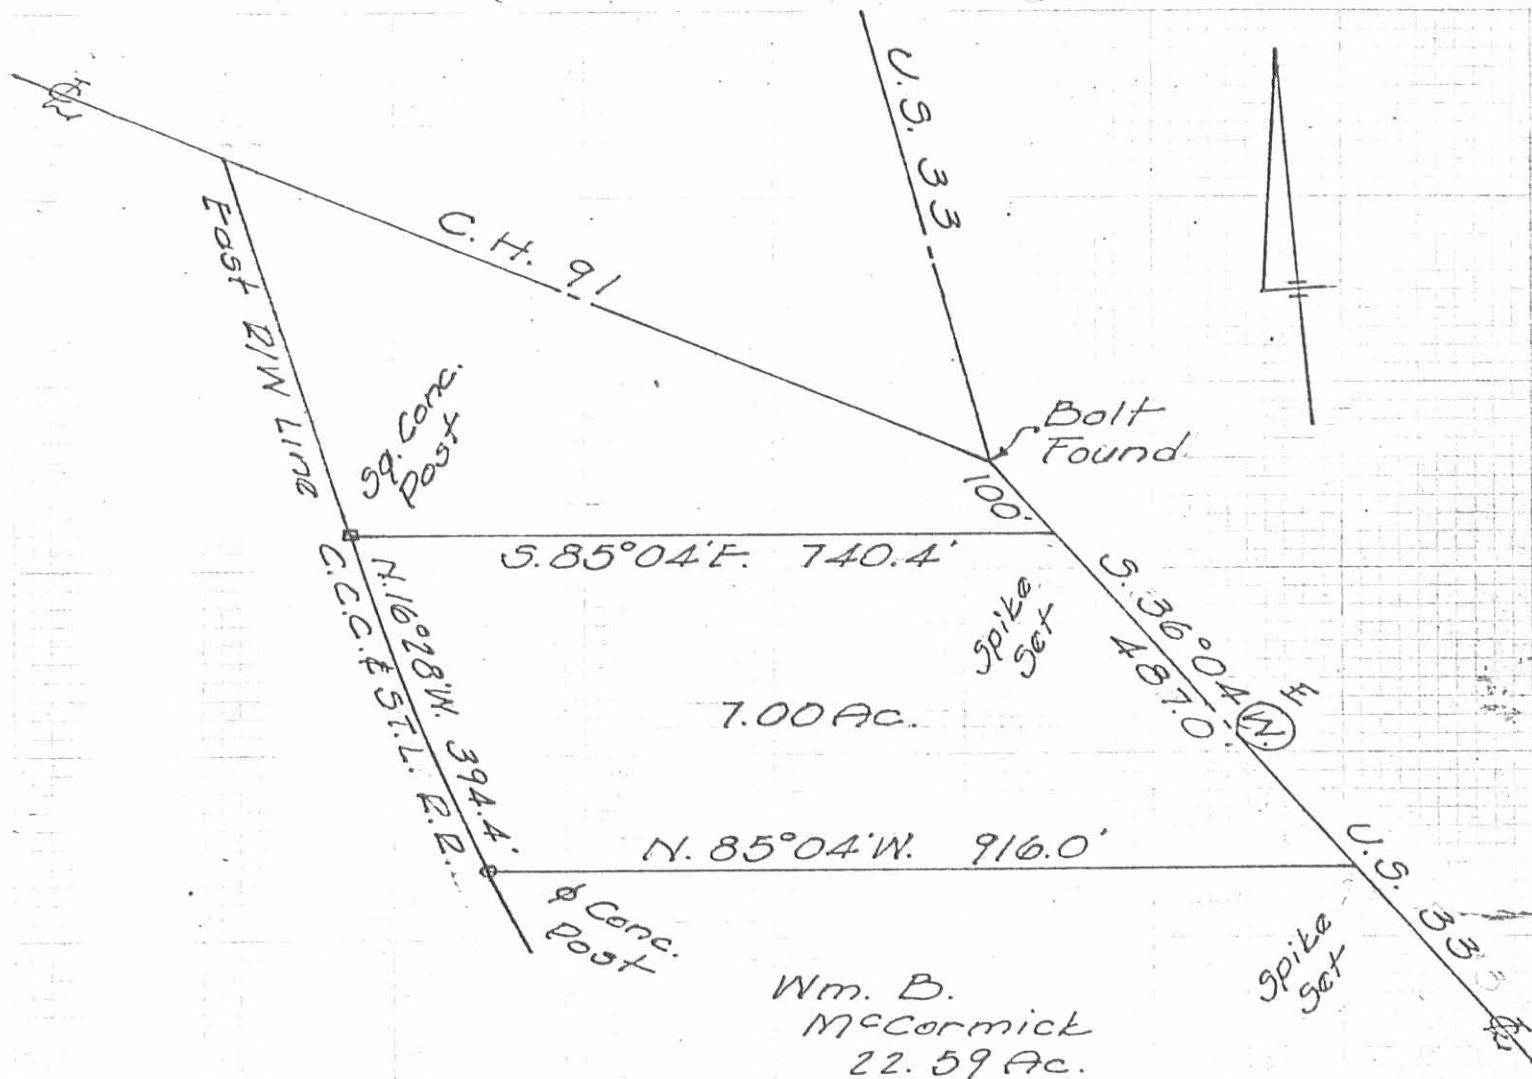

CLAGG SURVEY  
 SEC. 7, T-2, R-15  
 HARRISON. TWP.  
 LOGAN COUNTY, O.  
 SEPT. 9, 1964  
 SCALE 1" = 200'

ENDEARED ON MAP

6927  
 IP

REF:  
 Logan County Engineers  
 Field Book 521, Pg. 62

Dan L. Dodson  
 Dan L. Dodson  
 Reg. Surveyor 4270  
 Bellefontaine, Ohio




CLAGG SURVEY  
HARRISON TWP.

Iron found  
36

Dodson  
Tavis

2 hrs Sept. 1, 1964  
Sept 2, 1964

35

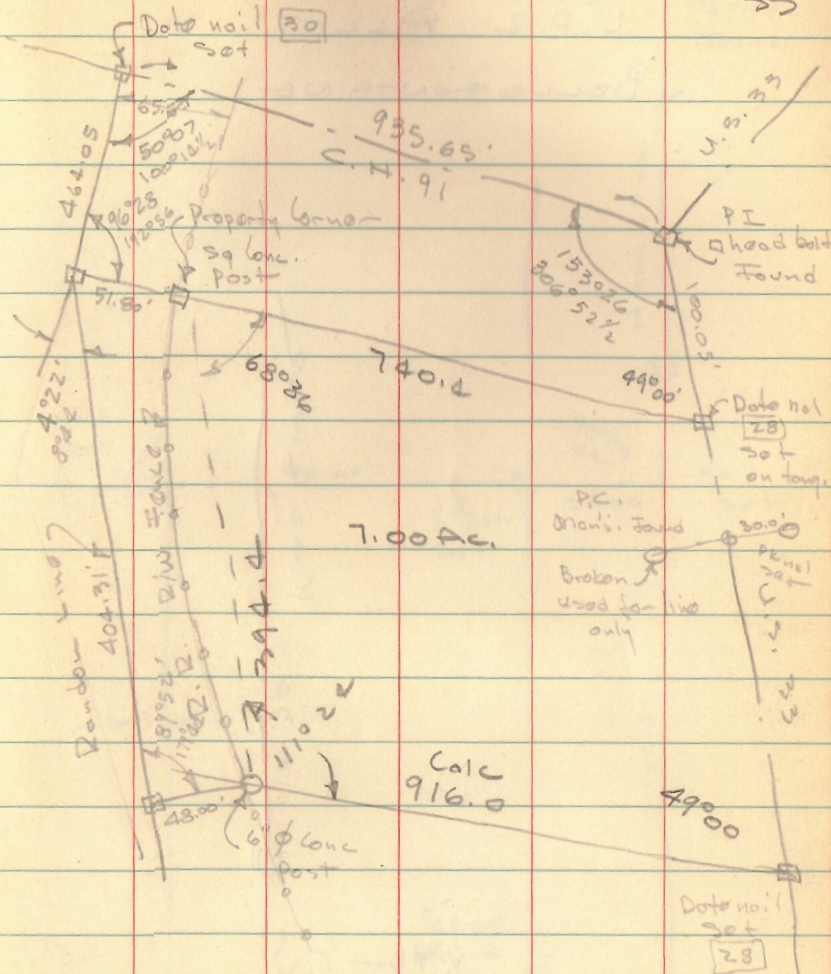

INDEXED ON MAP  
6927

INDEXED ON MAP  
6927