


Cent path track

124
125
126
First Lot 110 88.


Hunterville

Chas Heron


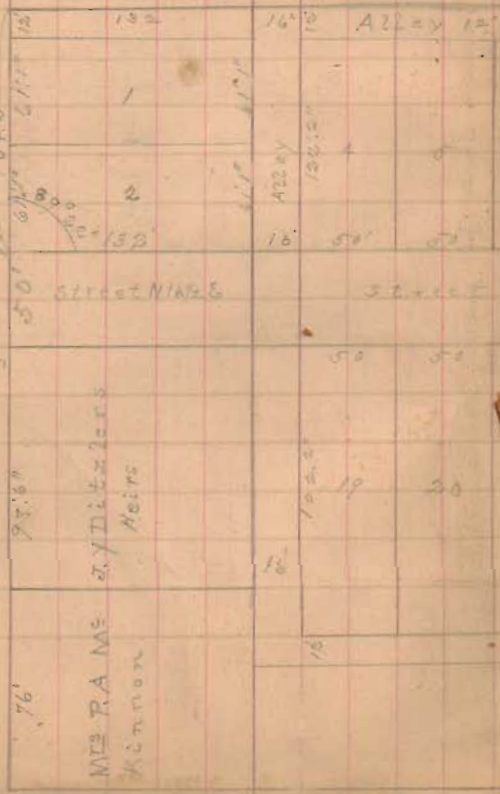


124
125
126
208 - 208 1/2 + 46
Andy Wulzoby
208 1/2

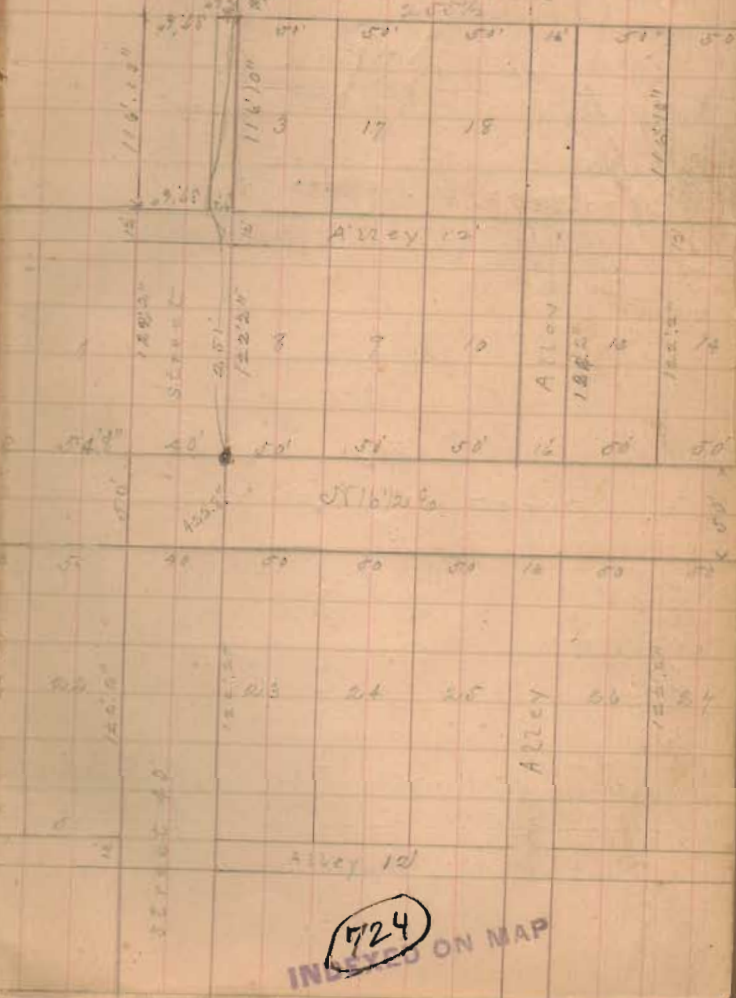

724
INDEXED ON MAP

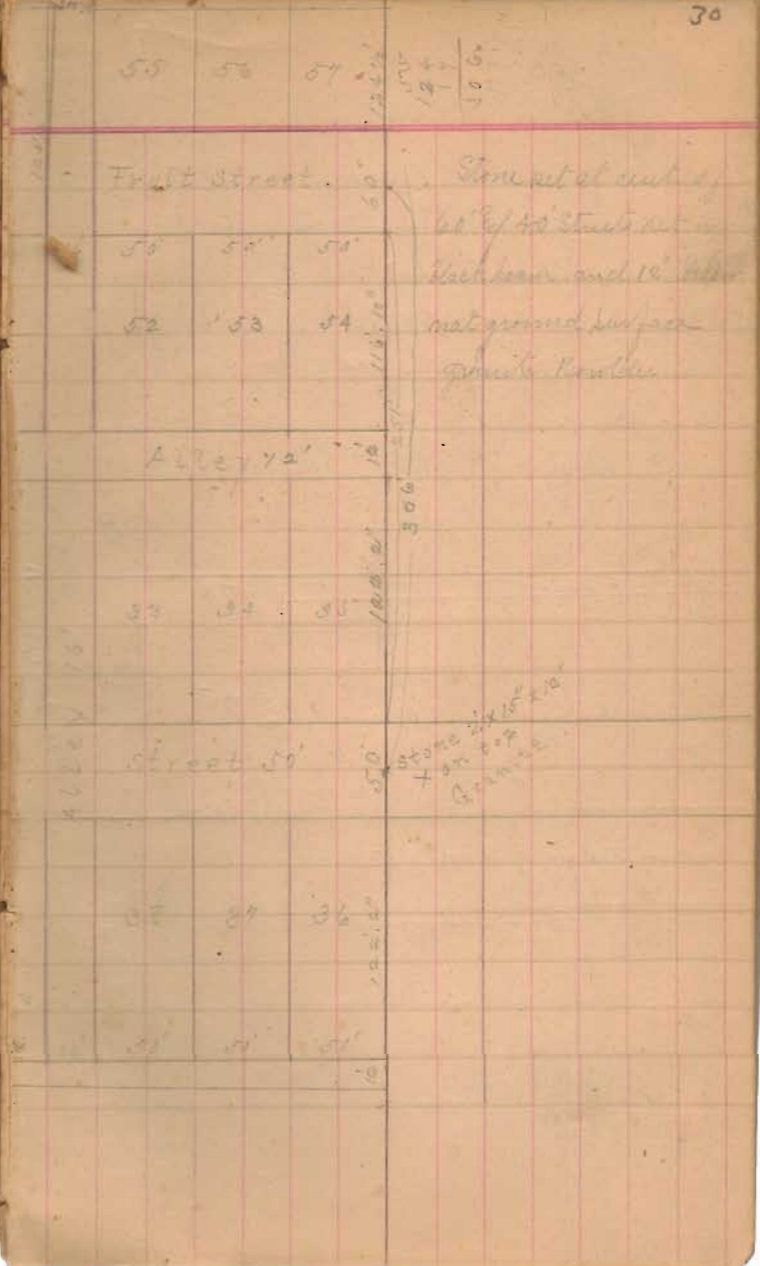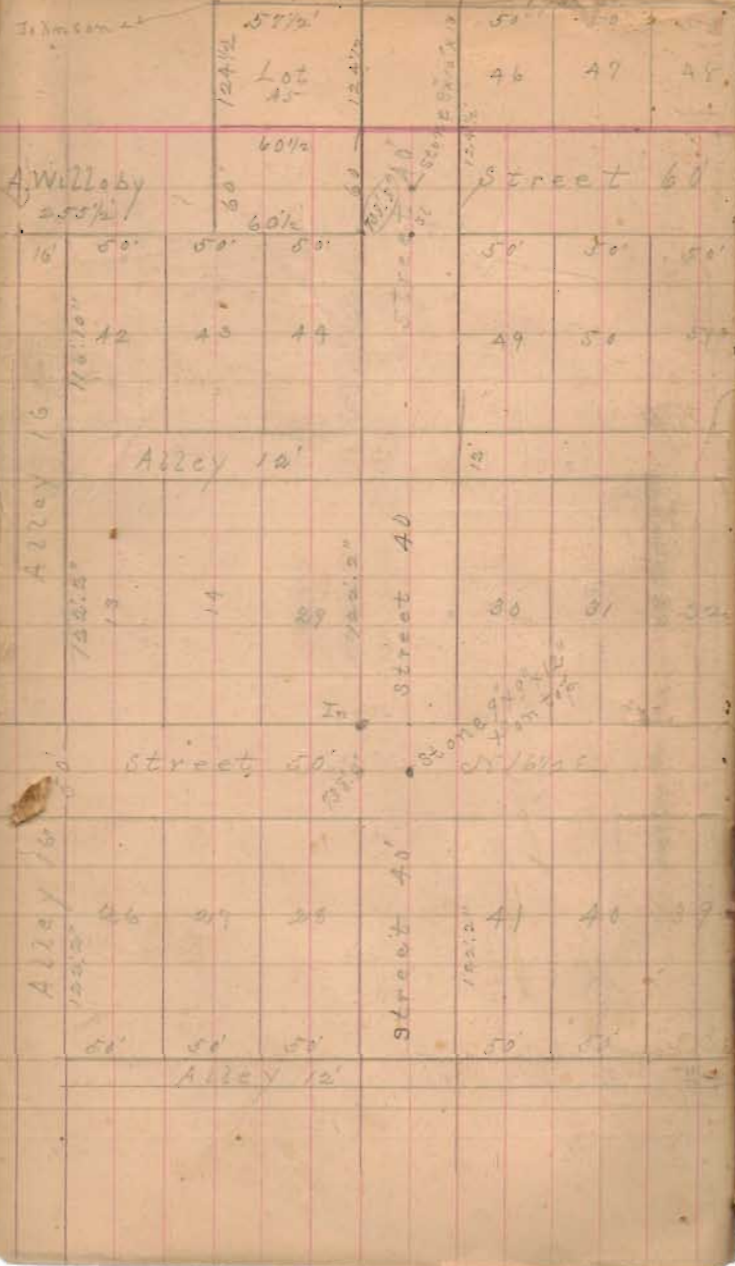

Stone set at center
 of 40' Street set
 back from and 10' below
 mat ground surface
 granite Boulder

Stone 9' x 15' x 10'
 + 27' x 27'
 granite

cont 134W Ry

Alley

A Wilbey 1.16a

Fruit Street

B.

Johnson 1a


192.5'



Street 40

Measure 17th Street

Measure from point on main track C. & N. Ry.
 to East side of 17th Street on Nap St 695 1/2'
 From curv. R. R. to east side Fruit St. North
 = 695 1/2' - 300 = 395 1/2' =
 same South = 695 1/2' - 300 = 395 1/2'

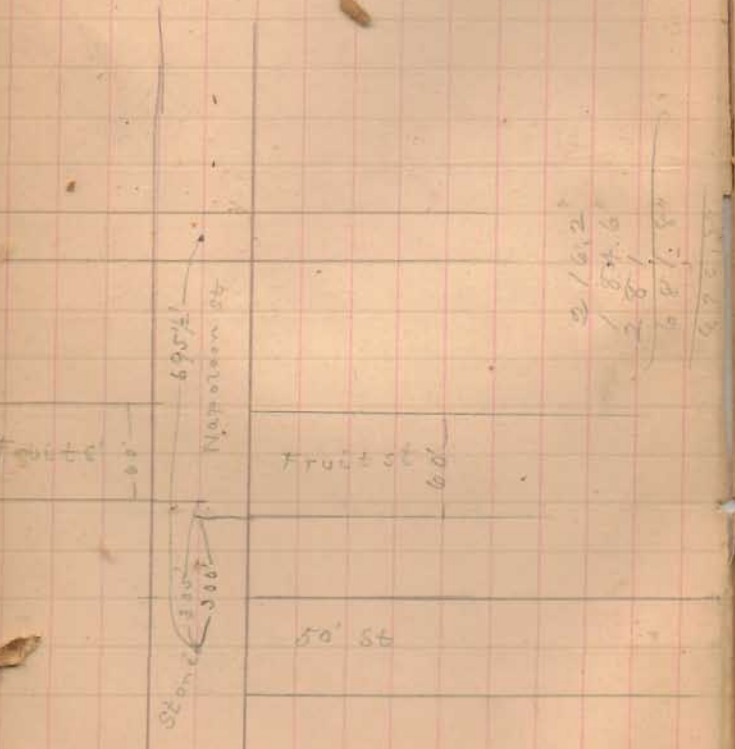

2 16.2
 1 84.6
 2 81
 6 87.5
 6 95.1

Lat 6.00. Oct 13-83

Linn Ward Linn

Start at stone ang of road cut = to
Eyer ²/₃ / ²/₃ Culp.

with road S 86 1/2 E 10.00 ch to stone
in cut road = Ward & King

16 links W of
Linn B. Start at stone in road = to
Ward & King thence with old fence
S 8 E, at 10.00 fall 33 links W of
fence, dip too small for 1/4 on 10 ch
at 10.22 on fence pass on side of block
oral tree 3 1/2 di and on E side 1 1/2 oral
stump 3 di, correct corner for fence N 9 E
13.5 ch outlet chan at SW = of lake, x end fence
and 1 chain west of surface of water in lake
and 1 chain east of line as cut by King fence
west line.

ditch at outlet about 6' deep.

Course of road stone at ang road = fence
and culp to = King & Archer S 86 1/4 E

Linn P. Start at quar line < SW = J. Miller
E / S E = G. Patterson

S 86 1/2 E 9 1/2 ch south
at 10.00 pass old cor stone or or = to
Linn Ward & King tract

at 30 3/4 chain line as cut to by King
and line cut straight from here to S. end lake


at 37.00 ch old fence on side of Ward & King
3/4 chain north of margin water in lake

38 1/4 ch chain from cut S 1/2 ch N of lake

40.00 yr line = 2 ch N of lake


42.00 lake 1 ch south

45.00 " 4 " " and N E = lake

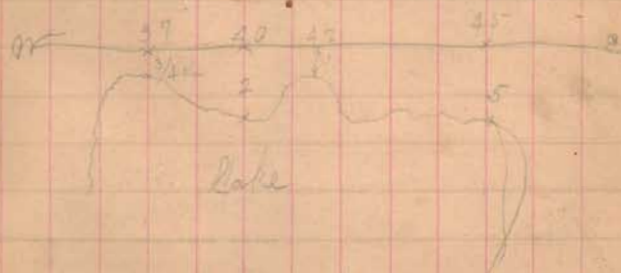

Oct 22 - 88

Ward and King
Course of RR cul from N
Junc S side lake N 1/4 E
Course from N end of Ward and
King Junc at S side lake N 13/4 E
to stake at NE Ward at 108 p.

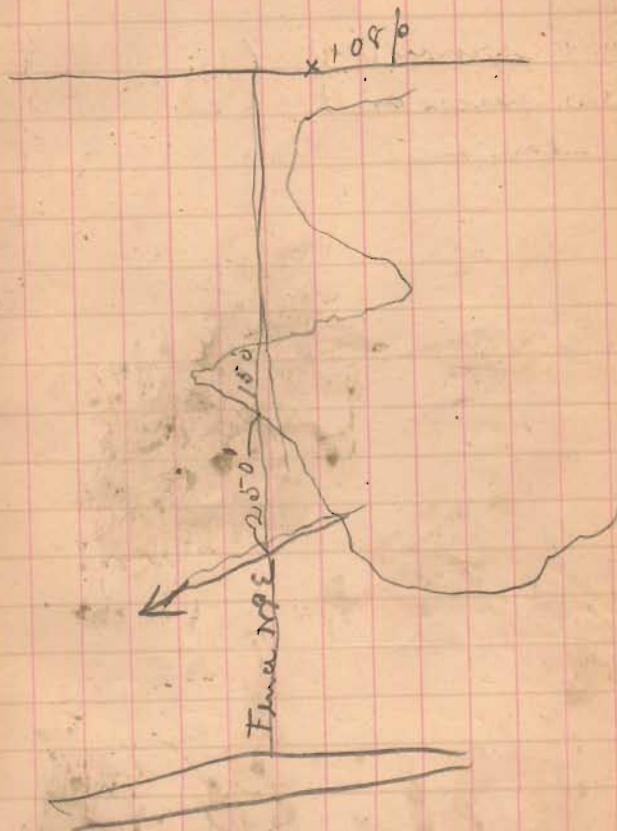


April 28 - 89

course of pike N 87 3/4 E 507.

" " M. Road N 8 1/2 W 327.

A. R. Lambert & Co. owners
S. S. Johnson

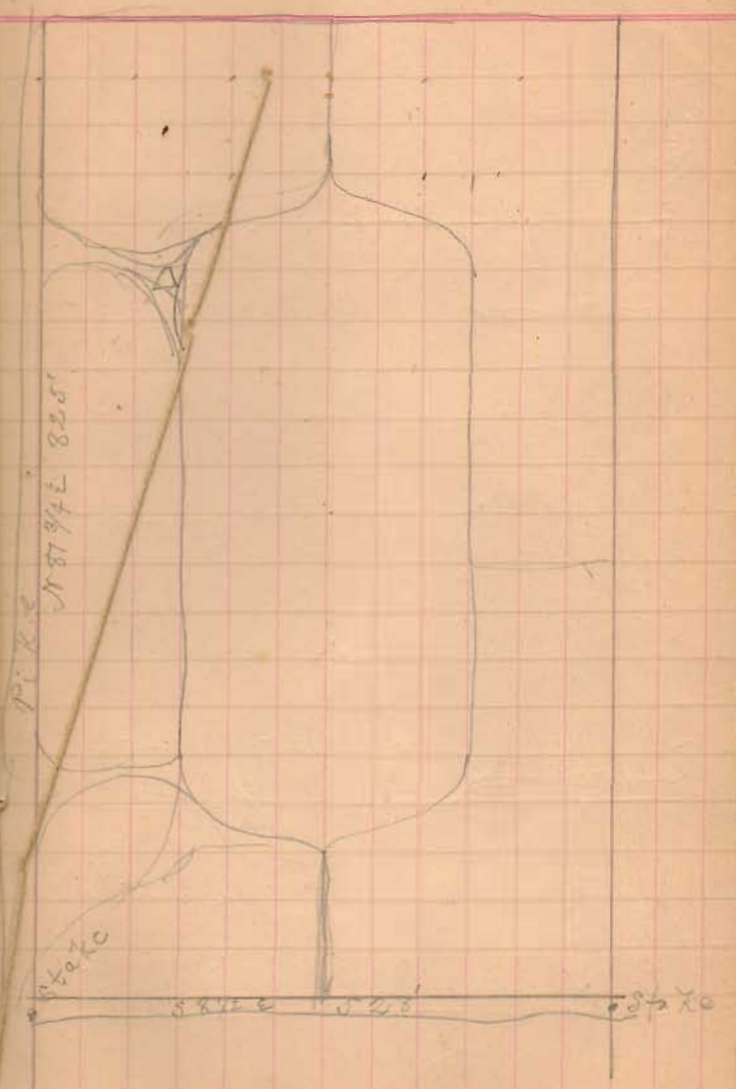


16.12.20

Polino field grass 3 x 10
lots E 18, 20 T 22.
N/S 12, 16 - 18, 20-22

E

6 margin walk

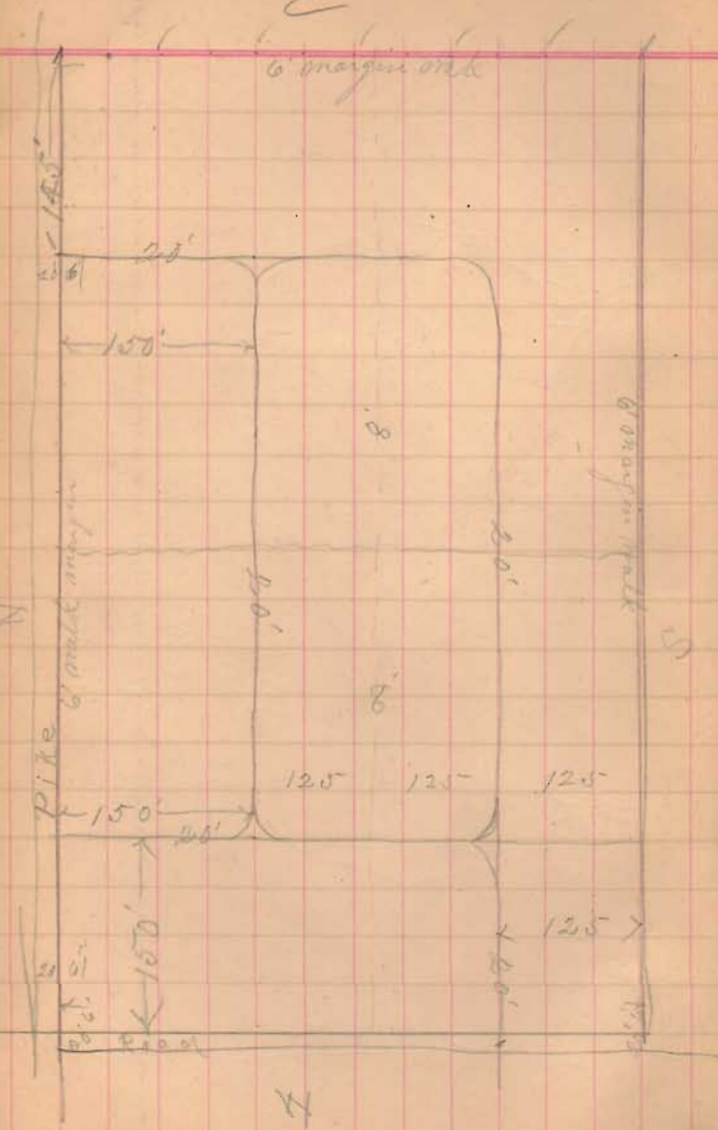

N