


SURVEY OF LOT NO 82 PART
VILLAGE OF HUNTSVILLE
M.C. ARTHUR TOWNSHIP
LOGAN COUNTY, OHIO
JULY 2, 1983


SCALE: 1" = 20'

SURVEYED AND PLATTED BY:
DANIEL E. GILBERT, P.S.
REG. SUR. NO. 5402
1041 N. MAIN ST.
BELLEFONTAINE, OHIO 43311

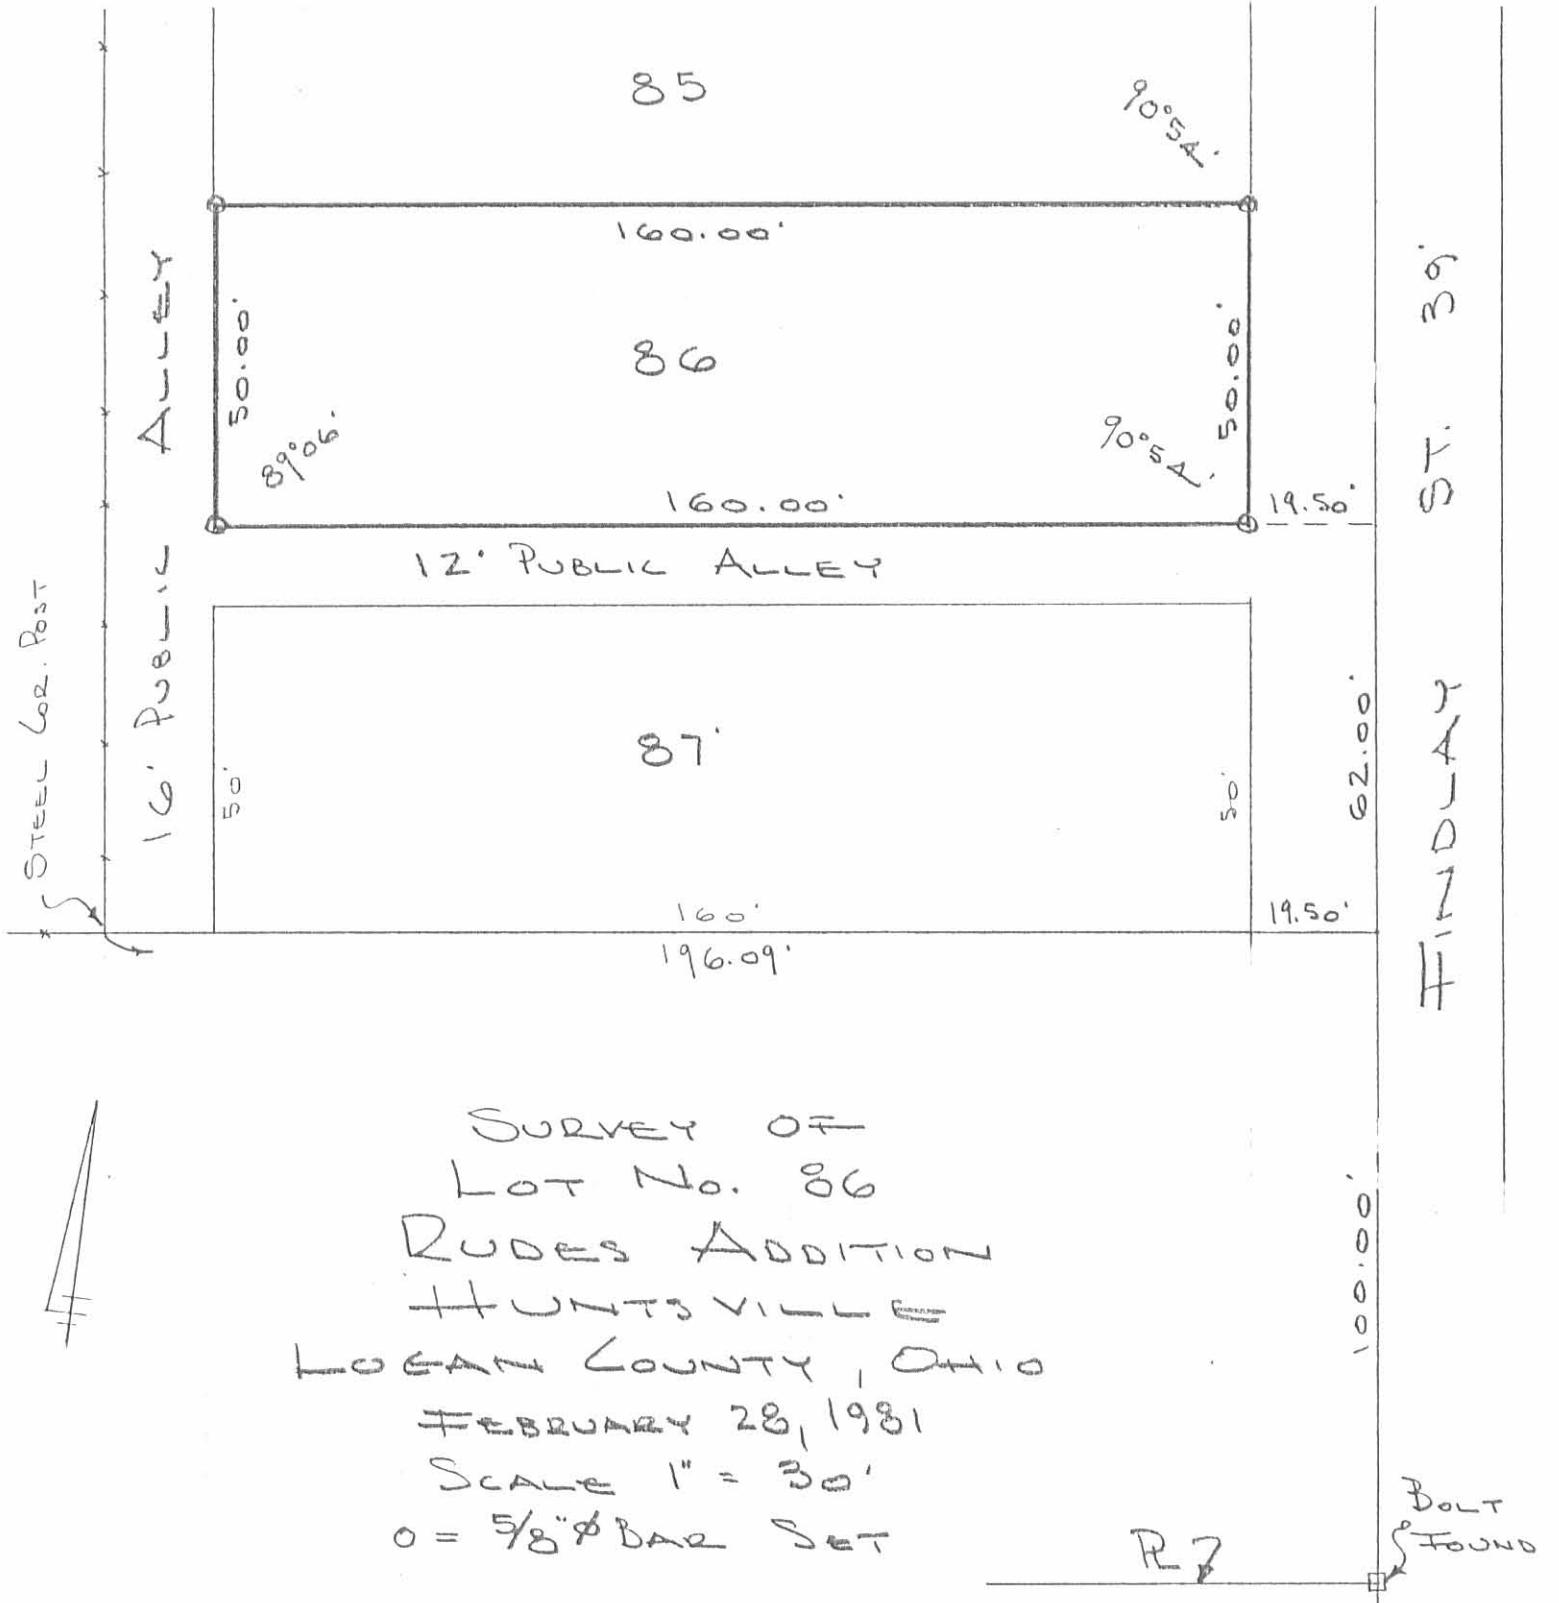

**INDEXED ON MAP
1865 2P**

DAN L. DOODSON
REG SURVEYOR A270
BELLFONTAINE, OH

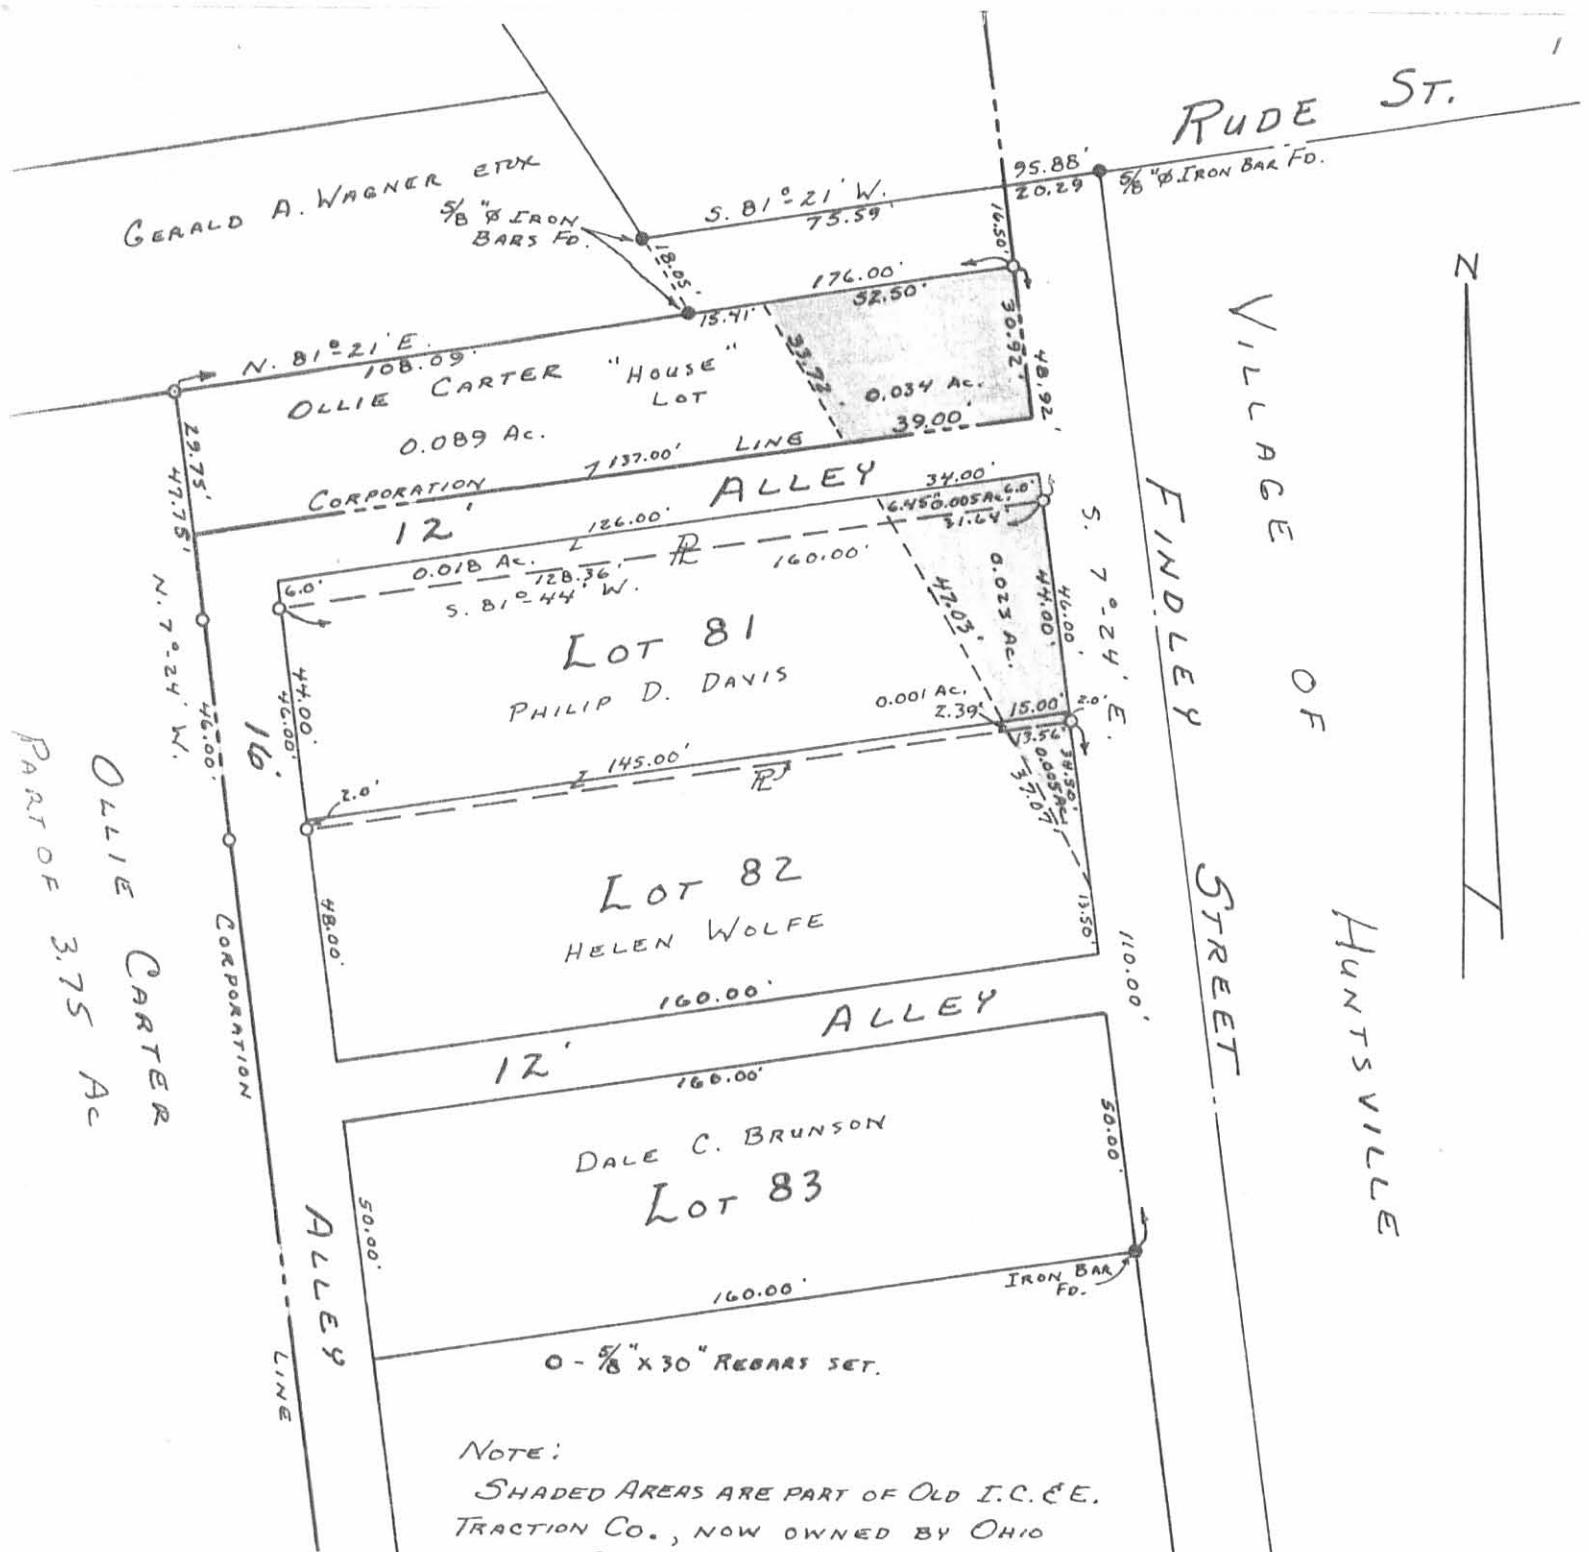

INDEXED ON MAP

(1865) 3P

SURVEYED AND PLATTED BY:
 DANIEL E. GILBERT, P.S.
 REG. SUR. NO. 5402
 1041 N. MAIN ST.
 BELLEFONTAINE, OHIO 43311

OLLIE CARTER SURVEY
 V.M.S. No. 9903-9928
 VILLAGE OF HUNTSVILLE
 M^cARTHUR TOWNSHIP
 LOGAN COUNTY, OHIO
 JUNE 5, 1982

SCALE: 1" = 40'

REC'D 8/15/90 SURV OKR

LESLIE H. GEESLIN
REGISTERED SURVEYOR 5248
P. O. BOX 274
RUSHSYLVANIA, OHIO 43347
TELEPHONE: (513) 468-2793

STEVELEY SURVEY

August 8, 1996

The following described real estate situated in the State of Ohio, County of Logan, Township of McArthur, being part of Virginia Military Survey 9903 and more particularly described as follows:

Beginning at a 3 inch angle iron post found at the intersection of the west corporation line of the Village of Huntsville with the north line of Lester Miller, etux's 0.75 acre tract as described in D. B. Vol. 377 Page 261.

Thence with said Miller's north line S. 81° 04' 45" W. 129.60 feet to a 5/8 inch iron bar found at the northeast corner of Richard Wilson, etux's 7.25 acre tract as described in D. B. Vol. 313 Page 290.

Thence with said Wilson's north line S. 81° 19' 39" W. 229.63 feet to a 3/4 inch iron pipe found in the east line of Opal G. Wagner, etal's 11.33 acre tract as described in O. R. Vol. 37 page 262.

Thence with said Wagner's east line N. 7° 41' 12" W. 427.91 feet to a stone found.

Thence with said Wagner's south line and the south line of Carl E. Wallace, etux's 0.31 acre tract as described in D. B. Vol. 350 Page 219 N. 81° 21' 00" E. 485.99 feet to a 5/8 inch iron bar set in the west line of a part of the Ohio Edison Co.'s tract as described in D. B. Vol. 159 Page 254.

Thence with Ohio Edison Co.'s west line on a 1393.70 foot radius curve to the right the chord of which measures S. 31° 22' 24" E. 33.22 feet to a 5/8 inch iron bar set in the north line of Rude's Addition to the Village of Huntsville.

Thence with the north line of said Addition S. 81° 42' 52" W. 136.71 feet to a 5/8 inch iron bar set.

Thence with the west line of said Addition S. 7° 11' 44" E. 397.51 feet to the place of beginning.

Containing 3.635 acres more or less.

The above described 3.635 acre tract being all of Michael L. Steveley, etux's 3.75 acre tract as described in O. R. Vol. 244 Page 517.

Bearings are based on an assumed bearing (N. 81° 21' 00" E.) for the south line of Opal G. Wagner, etal's 11.33 acre tract as described in O. R. Vol. 37 page 262 in this field survey by Leslie H. Geeslin, Reg. Surveyor 5248 on August 8, 1996.




Leslie H. Geeslin

LEGEND:

- = 5/8 INCH IRON
BAR FOUND
- ◎ = 3/4 INCH IRON
PIPE FOUND
- = 3 INCH ANGLE
IRON POST FOUND
- △ = STONE FOUND
- = 5/8 INCH IRON
PIPE FOUND

OPAL G. MAGNET, ETUX
0.11. 33 AC.
D.B. VOL. 37 PG. 262

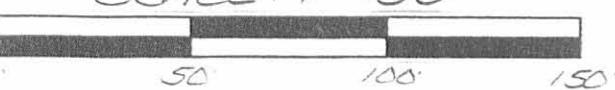SCALE: 1"=50'


N. 7041' 12" W.

S. 81° 19' 39" W. 229.63
RICHARD WILSON, ETUX
7.25 AC.
D.B. VOL. 313 PG 290

INDEXED ON MAP
1865 4P

N. 81° 21' 00" E.

MICHAEL L. STEVELEY, ETUX
3.75 AC.
O.R. VOL. 244 PAGE 517

3.635 AC.

S. 81° 04' 45" W. 129.60

LESTER MILLER, ETUX
0.75 AC.
D.B. 377 PAGE 261

CHORD:
S. 31° 22' 24" E.
33.22'
RADIUS:
1393.70'

485.99'
52.50'
S. 81° 42' 52" W. 136.71'
HUNTSVILLE CORP. LINE
12' ALLEY

CARL E. WALLACE, ETUX
0.31 AC
D.B. VOL. 350
PAGE 219

CHIO EDISON
CO.
D.B.VOL. 159
PAGE 254

FINDLAY STREET (39')

BLUDER'S ADDITION

HUNTSVILLE CORPORATION LINE ALLEY

397.51'

SURVEY OF 3.635 ACRES
IN VIRGINIA MILITARY SURVEY
9903, McARTHUR TOWNSHIP
LOGAN COUNTY, OHIO FOR
MICHAEL STEVELEY ON
AUGUST 8, 1996



LESLIE H. GEESLIN
PENNSYLVANIA, D
(513)468-2793

Survey of Property of Wm. H. Dodds et al


Part of Lots 81 & 82 Huntsville, Ohio

Deed Record Vol. 166 P. 4


1865

SP



INDEXED ON MAP

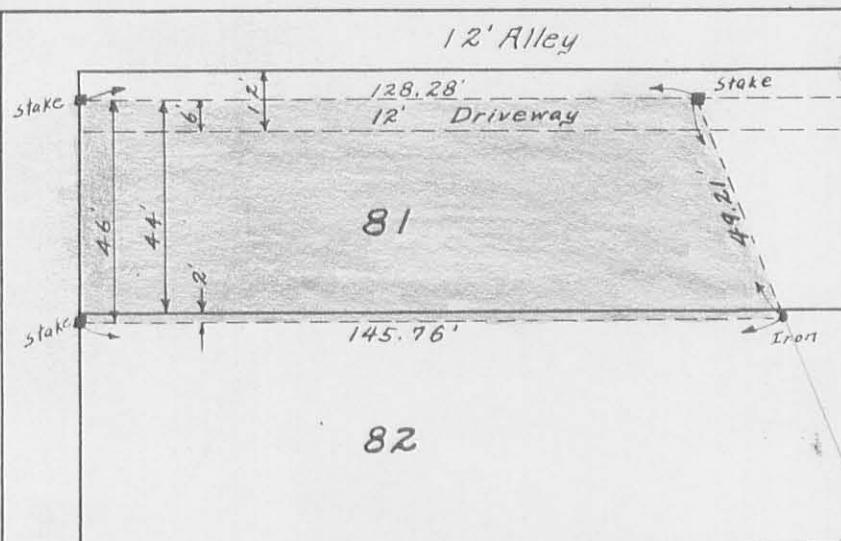

Scale: - 1" = 40'

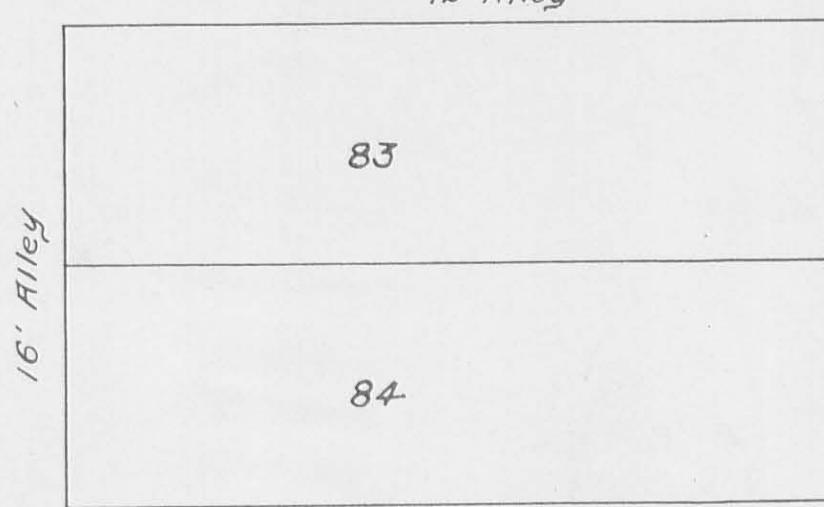

FINDLAY STREET

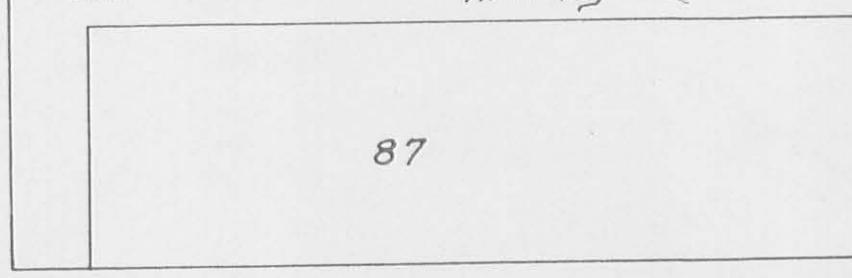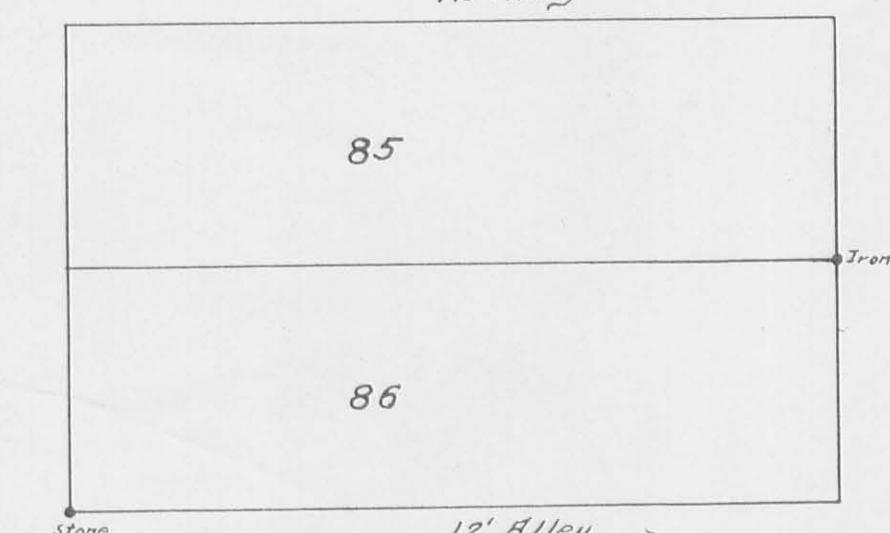

Rudes Addition to Huntsville
Book B Vol. 2 Page 56
Original Lots 50' X 160'

Nov 1939

E.K. Core

LESLIE H. GEESLIN
REGISTERED SURVEYOR 5248
P. O. BOX 274
RUSHSYLVANIA, OHIO 43347
TELEPHONE: (513) 468-2793

STEVELEY SURVEY

August 8, 1996

The following described real estate situated in the State of Ohio, County of Logan, Township of McArthur, being part of Virginia Military Survey 9903 in the Village of Huntsville and more particularly described as follows:

Beginning at a 5/8 inch iron bar set at the northwest corner of Phillip Davis' Pt. Lot 81 as described in D. B. Vol. 369 page 52.

Thence with said Davis' west line N. $7^{\circ} 11' 44''$ W. 6.00 feet to a 5/8 inch iron bar set at the northwest corner of Lot 81

Thence with the north line of said Lot 81 N. $81^{\circ} 42' 52''$ E. 125.75 feet to a 5/8 inch iron bar set in the west line of a part of the Ohio Edison Co.'s tract as described in D. B. Vol. 159 Page 254

Thence with said Edison's west line on a 1393.70 foot radius curve to the right the chord of which measures S. $28^{\circ} 48' 35''$ E. 6.41 feet to a 5/8 inch iron bar set in said Davis' north line

Thence with said Davis' north line S. $81^{\circ} 42' 52''$ W. 128.11 feet to the place of beginning.


Containing 0.017 acre more or less.

The above described 0.017 acre tract being all of Michael Steveley, etux's Pt. Lot 81 as described in O. R. Vol. 244 page 517.

Bearings are based on an assumed bearing (S. $7^{\circ} 11' 44''$ E.) for the west side of Findlay St. in this field survey by Leslie H. Geeslin, Reg. Surveyor 5248 on August 8, 1996.



MC A:\04\STEVELY1.SAM

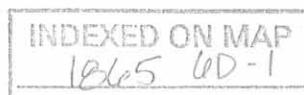

LESLIE H. GEESLIN**REGISTERED SURVEYOR 5248****P. O. BOX 274****RUSHSYLVANIA, OHIO 43347****TELEPHONE: (513) 468-2793****STEVELEY SURVEY**

August 8, 1996

The following described easement situated in the State of Ohio, County of Logan, Township of McArthur, being part of Virginia Military Survey 9903 in the Village of Huntsville and more particularly described as follows:

Beginning at a 5/8 inch iron bar set at the southwest corner of Michael Steveley, etux's Pt. Lot 81 as described in O. R. Vol. 244 page 517.

Thence with said Steveley's south line N. $81^{\circ} 42' 52''$ E. 128.11 feet to a 5/8 inch iron bar set in the west line of a part of the Ohio Edison Co.'s tract as described in D. B. Vol. 159 Page 254

Thence with said Edison's west line on a 1393.70 foot radius curve to the right the chord of which measures S. $28^{\circ} 48' 35''$ E. 6.41 feet to a point.

Thence S. $81^{\circ} 42' 52''$ W. 130.47 feet to a 5/8 inch iron bar set in the east line of a 16.00 foot alley.

Thence with the east line of said alley N. $7^{\circ} 11' 44''$ W. 6.00 feet to the place of beginning.


The above described 6.00 foot easement being on the north side of Phillip Davis' Pt. Lot 81 as described in D. B. Vol. 369 Page 52.

Bearings are based on an assumed bearing (S. $7^{\circ} 11' 44''$ E.) for the west side of Findlay St. in this field survey by Leslie H. Geeslin, Reg. Surveyor 5248 on August 8, 1996.



MICHAEL STEVELEY, ETUX
3.75 AC.
O.R VOL. 294 PAGE 517

12' ALLEY

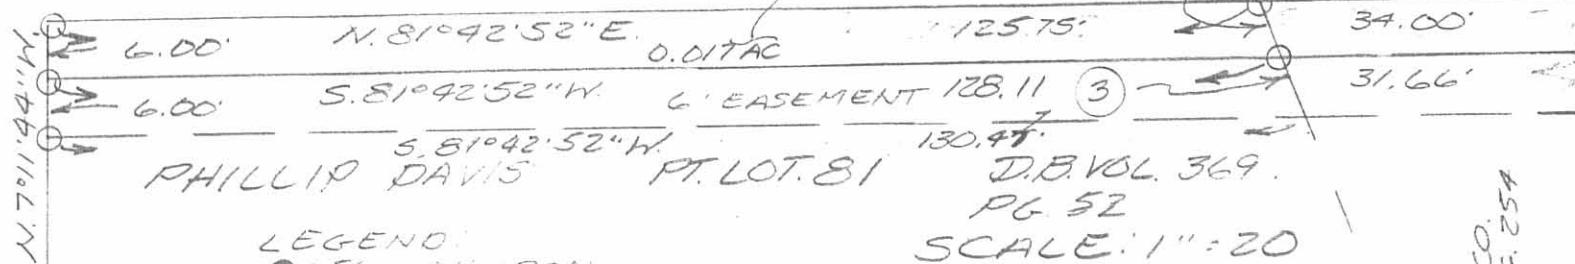

S. 70° 11' 44" E.
FINAL STREET (39)

OHIO EDISON CO.
D.B.VOL. 159 PG. 254



SURVEY OF PT. LOT 81 OF
RUDE'S ADDITION TO THE
VILLAGE OF HUNTSVILLE
VIRGINIA MILITARY SURVEY 9903.
MCARTHUE TOWNSHIP LOGAN
COUNTY, OHIO FOR MICHAEL
STEVELEY ON AUGUST 8, 1996

INDEXED ON MAP
1865 6P

Leslie H. Geeslin
LESLIE H. GEESLIN
RUSHSYLVANIA OH
(513) 468-2795


Lot No. 86
HUNTSVILLE, OHIO

- A = $\frac{5}{8}'' \varnothing$ Head bolt Found 6" deep BK $3\frac{3}{5}$ /S $4\frac{1}{3}$
- B = R.R. Spk. Found
- C = " "
- D = $\frac{5}{8}'' \varnothing$ BAR FOUND BK 18/50
- E = 1" \varnothing BAR Found
- F = $\frac{5}{8}'' \varnothing$ BAR Set
- G = " " "
- H = Steel Lg. Post
- I = $\frac{5}{8}'' \varnothing$ Bar Set
- J = " " "

Note $\frac{5}{8}'' \varnothing$ BARS Found on all Corners of lot 87, Set by D. Gilbert
Mr Brunson owner of lot 83 pointed out stones at "I" which was supposed to be lot 80. — it did not check with Irons Found @ F & E. — I ran traverse to tie all found points together — nothing fit very good — the only control on the recorded plot is the mention of the south line of lot 87 as the south line of Rudos land — used point 100.00 north of "A" & steel post at "H" as Rudos south line — made lots fit this line "Looks ok"

Dodson
Dirt

21 Feb. 81
60°

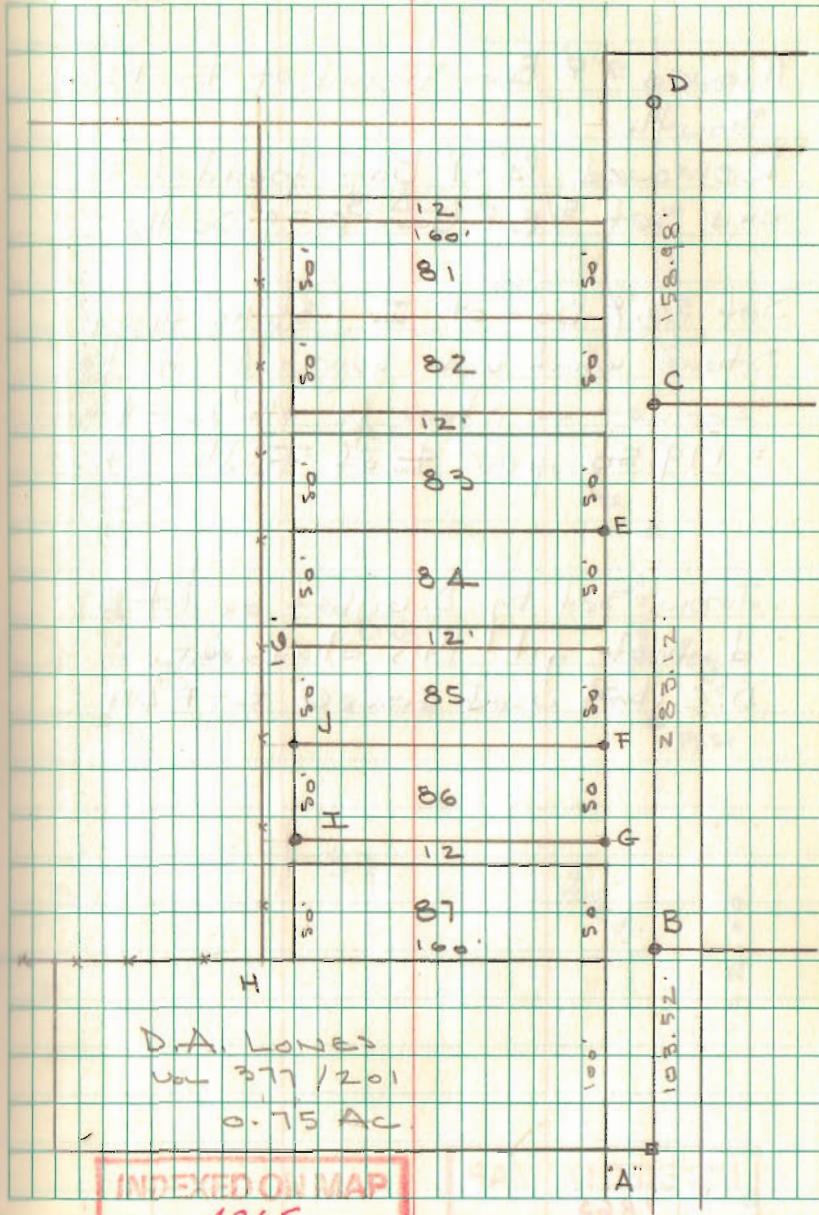

Lot No. 86
Huntington, Ohio

Moved 1"φ Bar Found at E 1.22'
South

Removed $\frac{1}{4}'' \times 1''$ Bar found at F
and Set $\frac{5}{8}'' \phi$ Bar 0.79' South

Set $\frac{5}{8}'' \phi$ Bar at I 1.35' north of
stone which was supposed to be
corner - stone is off East & west
= 179.50' from E of Friday St.


Irons set by D. Gilbert on lot 87
do not fit this alignment.

D. Gilbert used Irons @ E-F & H

Dodson
D.L.

2 Mar 81
45°

10

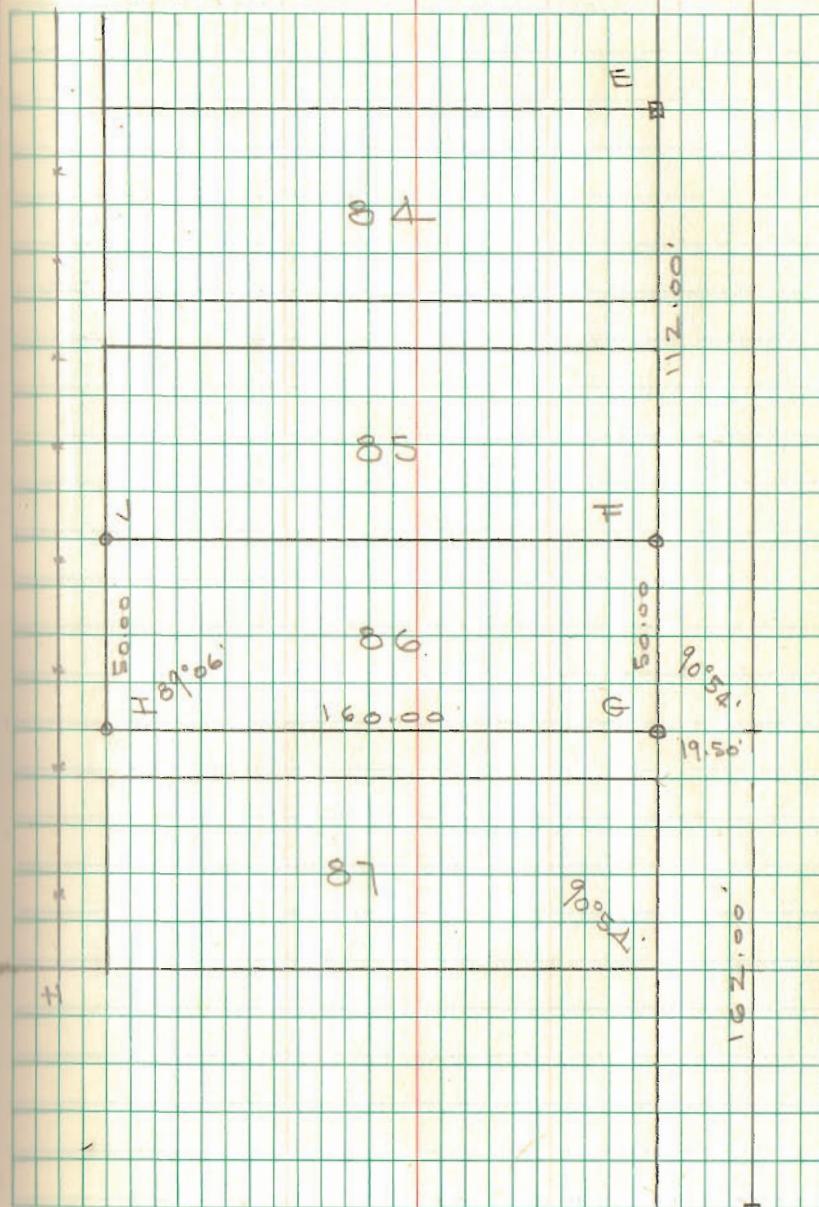

INDEXED ON MAP
1865

REC'D 1-18-11 SWYOK

16 FEET WIDE ALLEY

RUDE ADDITION
PLAT CABINET A, SLIDE 163

LOT 84

JANICE L. PAULEY
LOT 84
O.R. 193, PG. 611

BASIS FOR BEARINGS
S 06°58'12" E


ORDINANCE 665
VACATED 12 FOOT WIDE ALLEY
O.R. 600, PG. 13

N 82°09'06" E
159.77'

LOT 85

WILLIAM H. JENKINS AND BRENDA A. WALE
LOT 85
O.R. 481, PG. 877

FINDLAY STREET 39 FEET WIDE

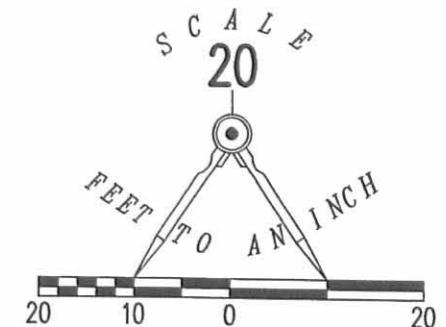

LEGEND

- 5/8 INCH IRON ROD SET WITH PLASTIC ID CAP STAMPED "LSM 7437"

SURVEY OF THE CENTER-LINE OF A
VACATED 12 FOOT WIDE ALLEY
OFFICIAL RECORD 600, PAGE 13
VIRGINIA MILITARY SURVEY 9903-9928
VILLAGE OF HUNTSVILLE
MCARTHUR TOWNSHIP
LOGAN COUNTY, OHIO

SURVEYED BY:



WILLIAM K. BRUCE
PROFESSIONAL SURVEYOR 7437
JANUARY 13, 2011

COPYRIGHT 2011 BY:
LEE SURVEYING & MAPPING CO., INC.
117 North Madriver Street
BELLEFONTAINE, OHIO 43311
(937) 593-7335
surveys@lsminc.us
ADW D0111 50800111 L-50800111-3



CALL TOLL FREE 800-362-2764

OHIO UTILITIES PROTECTION SERVICE

