



Brooks Survey Huntsville V.M.S. 9904 April 1949 0.25 Acre

The following described land in the Village of Huntsville, McArthur Township Logan County Ohio, and being in V.M.S. 9904

Beginning at the S.W. corner of Lot Number 65 said point being 3.80 feet from an iron at the east edge of the east sidewalk of Fruit Street thence with the East side of Fruit Street S. $14^{\circ} - 00'$ W. 65.00 feet to a point which is 3.80 feet east of an iron at the east edge of the east sidewalk of Fruit Street thence S. $80^{\circ} - 28'$ E. 165.00 feet to an iron pipe thence N. $14^{\circ} - 00'$ E. 65.00 feet to an iron at the S.E. corner of Lot Number 65 thence with the South side of Lot Number 65 N. $80^{\circ} - 28'$ W. 165.00 feet to the place of beginning said tract containing 0.25 of one acre.

3090 1b

INDEXED ON MAP

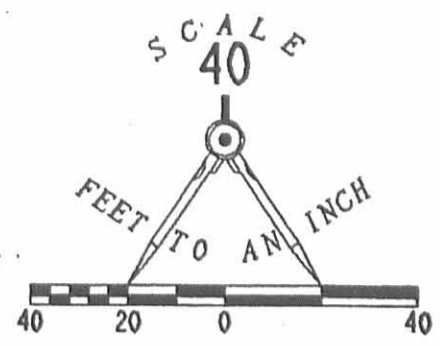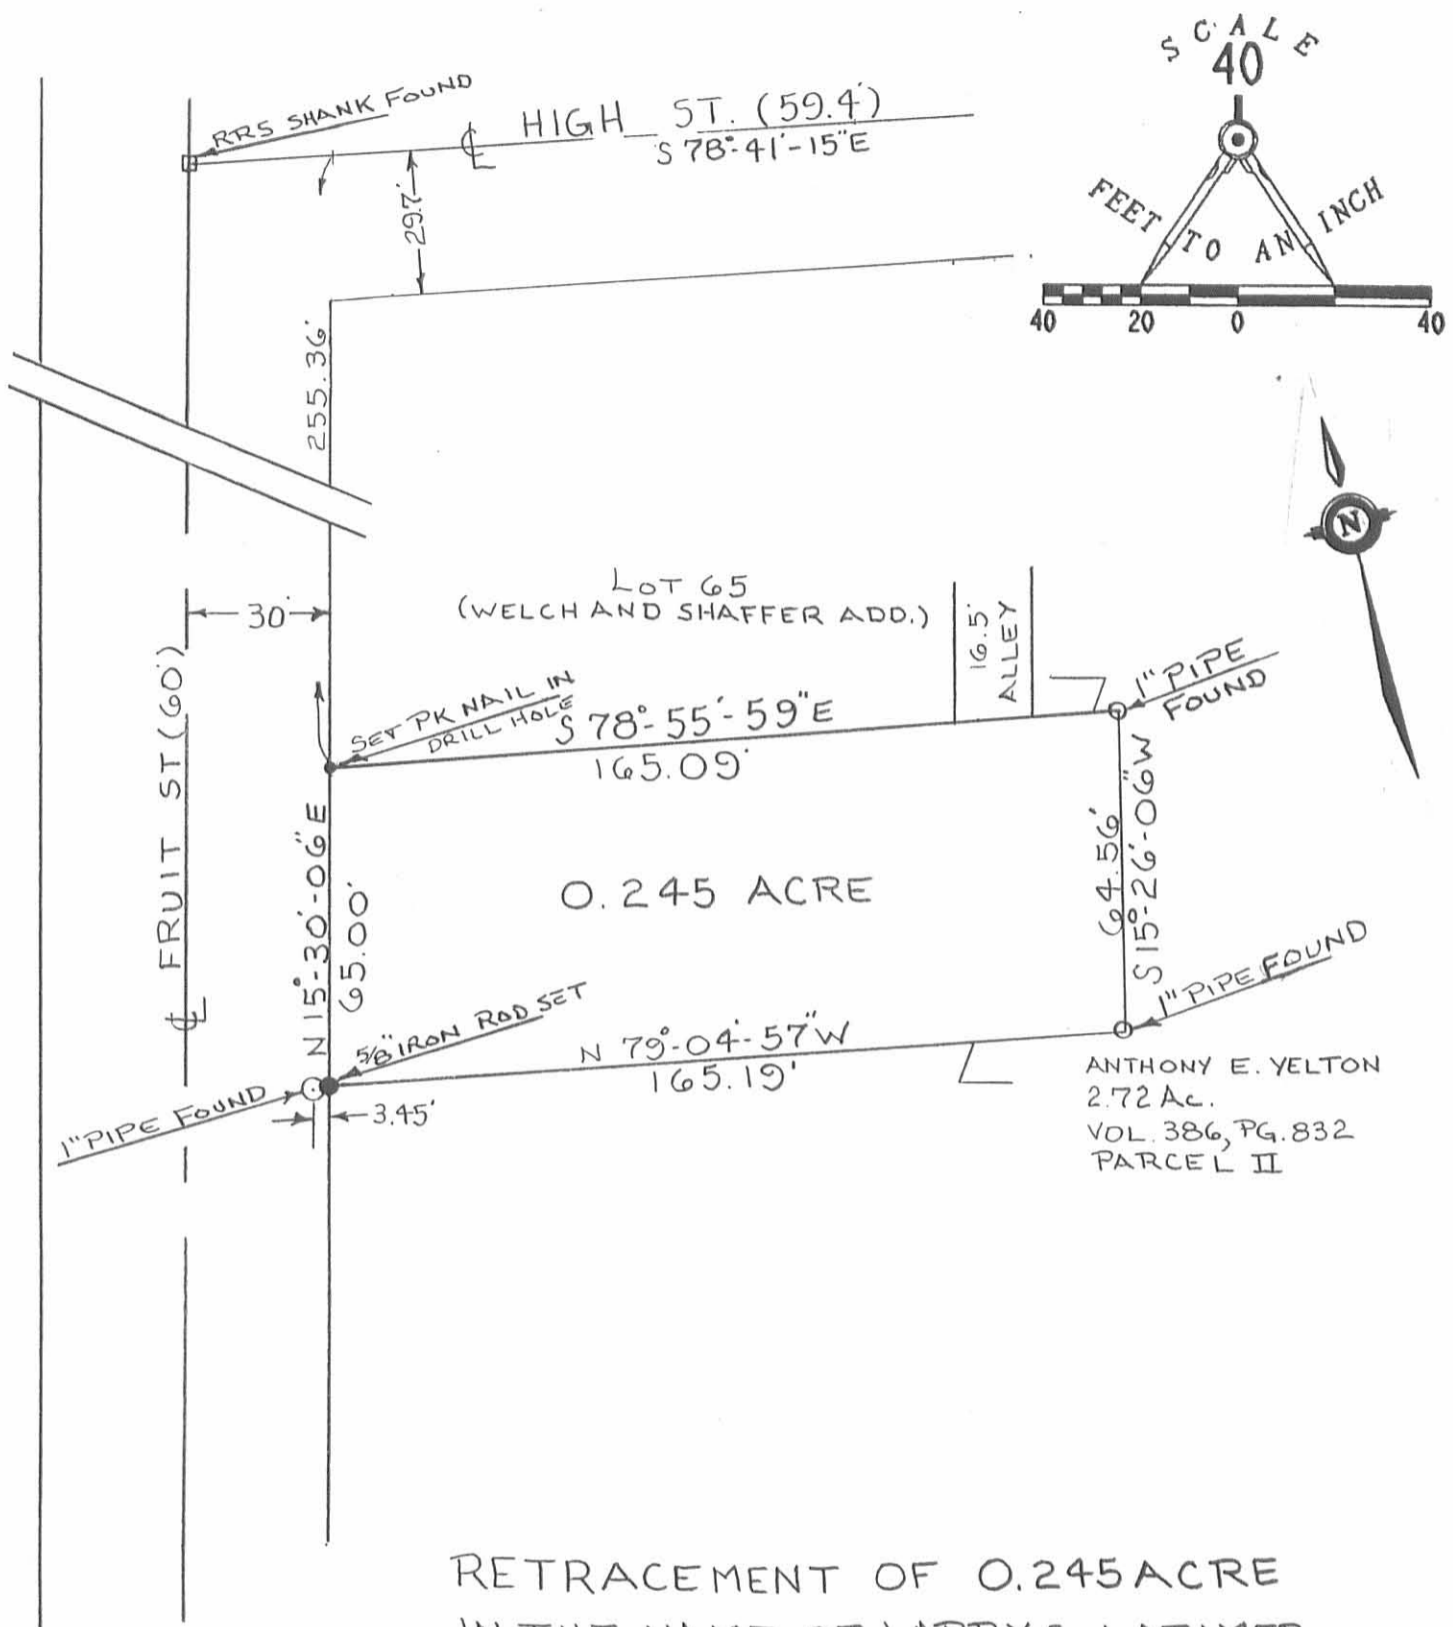

RETRACEMENT OF 0.245 ACRE
 IN THE NAME OF LARRY S. LATIMER
 O.R. 127, PG. 36 (0.25 Ac. DEED)
 V.M.S. 9904, VILLAGE OF HUNTSVILLE
 McARTHUR TOWNSHIP
 LOGAN COUNTY, OHIO

REFERENCES:
 LOGAN COUNTY ENGINEER'S
 FIELD BOOK 702, PG. 29
 FIELD BOOK 700, PG. 23



By William K. Bruce
 WILLIAM K. BRUCE
 PROF. SURVEYOR #7437
 AUGUST 14, 1992

INDEXED ON MAP
 3090 2P

L 2033-4