



1/2" IRON PIPE FOUND

• - 3/8" ϕ IRON BARS SET.

4312 IP

INDEXED ON MAP


SURVEYED AND PLATTED BY:
 DANIEL E. GILBERT, P.S.
 REG. SUR. No. 5402
 428 N. MADRIVER ST.
 BELLEFONTAINE, OHIO 43311



PAUL M. CORMICK SURVEY
 Y.M.S. No. 9904
 VILLAGE OF HUNTSVILLE
 M. ARTHUR TOWNSHIP
 LOGAN COUNTY, OHIO
 SEPTEMBER 24, 1968
 SCALE: 1" = 40'

CHRISTINE DR.

'69'

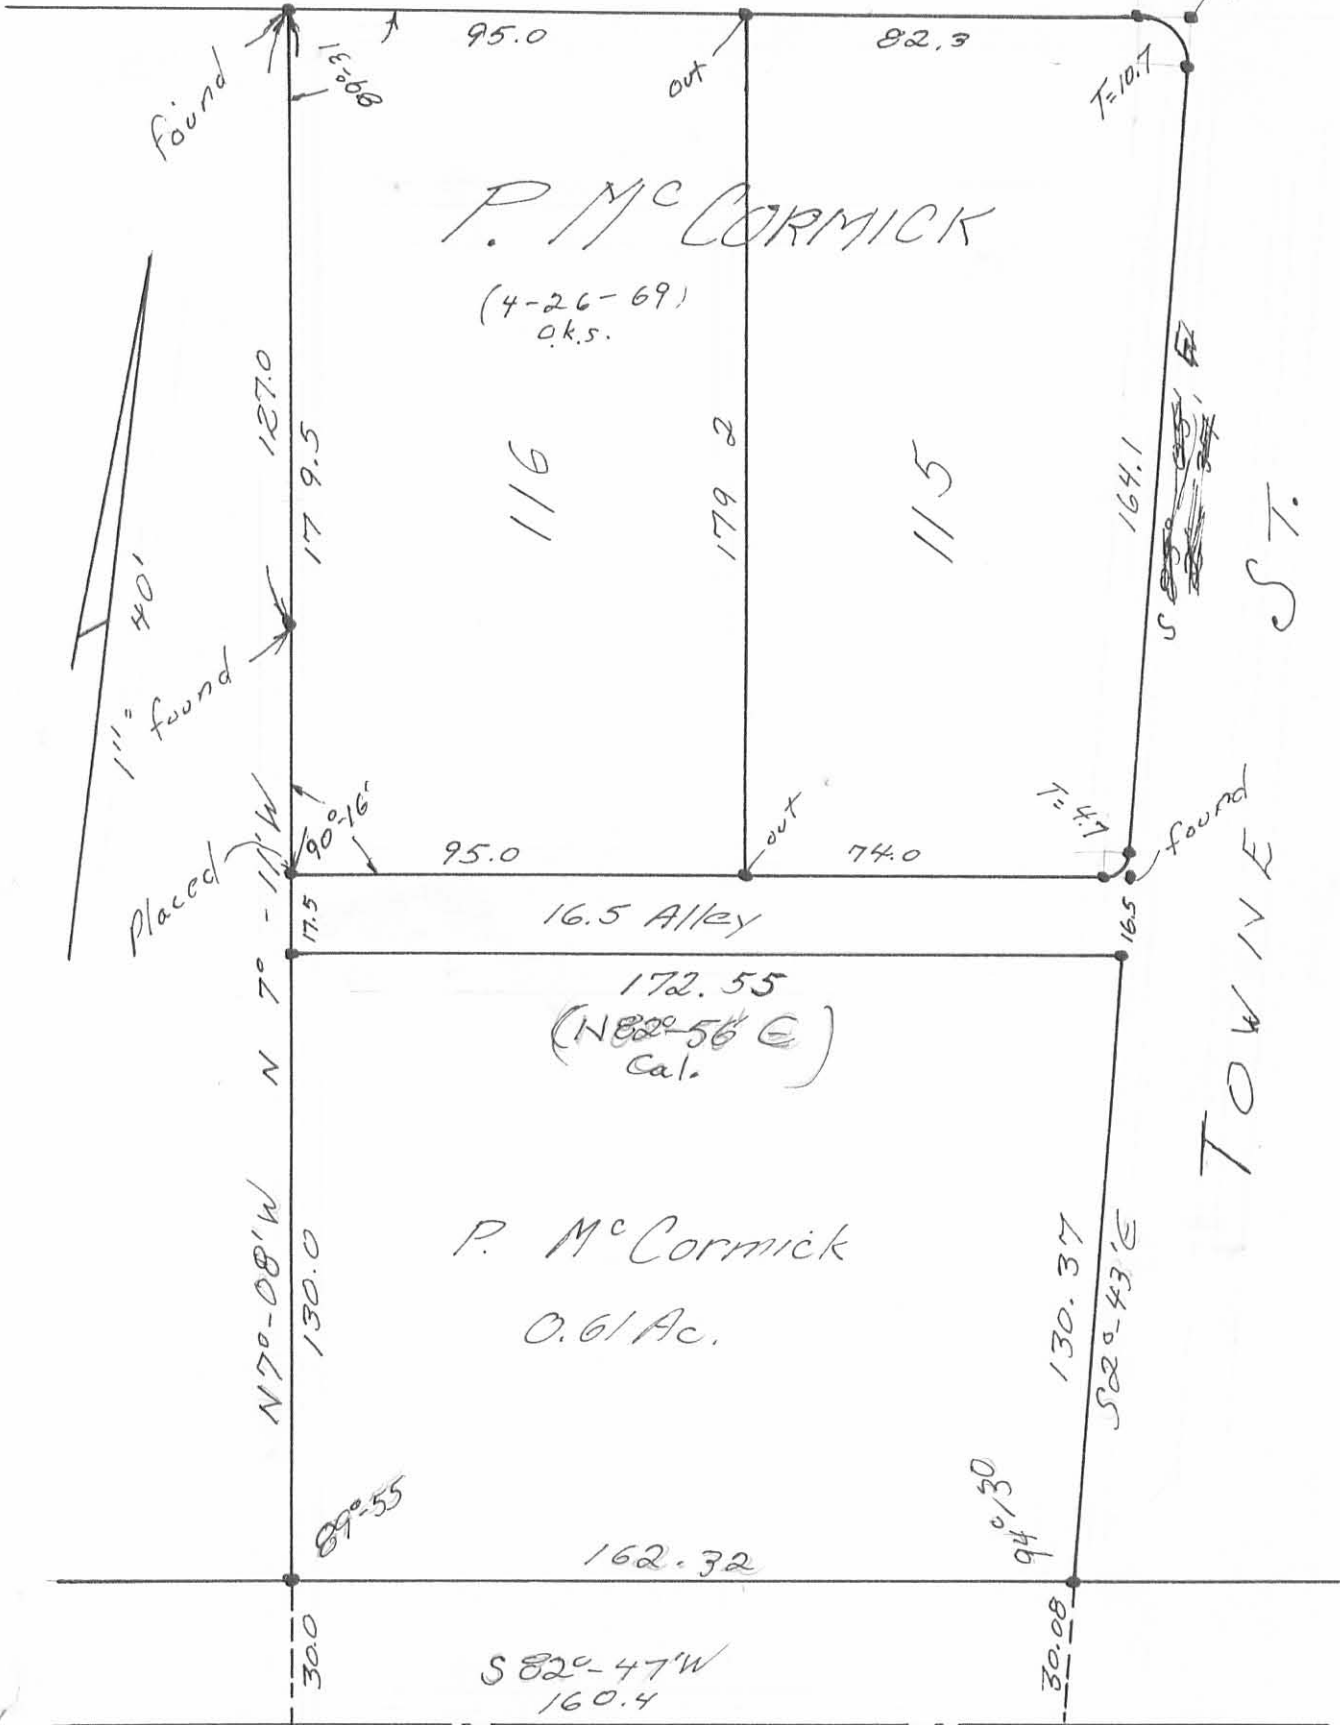

STATE ROUTE 274

INDEXED ON MAP
4312 2P