

Knights of Pythias
Huntsville Lodge No. 656
Huntsville, Ohio

The following described real estate situated in the Village of Huntsville,
Township of McArthur, County of Logan, State of Ohio and being a part of Virginia
Military Survey No. 9904 and being more particularly described as follows:

Beginning at the southeast corner to the present brick building (known as the
Knights of Pythias hall), said corner being in the west right of way line of the
C. C. C. & St. L. RR. (new Penn Central) and the north line of Napoleon Street;

Thence with the north line of Napoleon Street, N. $73^{\circ} 22'$ W. 34.05 feet to
an iron pipe, southeast corner to Lulu P. Reldan's present 0.10 Acre tract, said
iron pipe being S. $73^{\circ} 22'$ E. 45.80 feet from an iron bar at the intersection of
the north line of Napoleon Street and the east line of Wishart Street;

Thence with the east line of Reldan's tract, N. $17^{\circ} 00'$ E. 70.20 feet to an
iron pipe, said iron pipe being N. $73^{\circ} 06'$ W. 3.00 feet from the northwest corner
to said brick building;

Thence with the north line of Reldan's tract, N. $73^{\circ} 06'$ W. 78.00 feet to an
iron pipe in the east line of Wishart Street, said iron pipe being N. $7^{\circ} 35'$ W. 77.35
feet from an iron bar at the intersection of the east line of Wishart Street and the
north line of Napoleon Street;

Thence with the east line of Wishart Street, N. $7^{\circ} 35'$ W. 33.35 feet to an iron
bar at the southwest corner to Byron O. Yeutsey's 0.07 Acre tract;

Thence with the south line of Yeutsey's tract, S. $73^{\circ} 23'$ E. 100.70 feet to an
iron bar, southeast corner to Yeutsey and being in the west line of a tract belonging
to Darwin H. Crefut;

Thence with Crefut's west line, S. $17^{\circ} 01'$ W. 3.90 feet to an iron bar, Crefut's
southwest corner;

Thence with Crefut's south line, S. $73^{\circ} 51'$ E. 25.01 feet to an iron bar in the
west right of way line of the C. C. C. & St. L. RR. (new Penn Central), said iron
bar being Crefut's southeast corner;

Thence with the west right of way line of the C. C. C. & St. L. RR. (new Penn
Central), S. $16^{\circ} 52'$ W. 97.31 feet to the place of beginning, passing the northeast
corner to said brick building at 27.01 feet, containing 0.136 Acres, more or less.

INDEXED ON MAP
5775 ID-1


(2)

The above described tract being all that remains in the name of the Knights
of Pythias Huntsville Ledge No. 656 as recorded in Deed Vol. 113 Page 179 (2-28-1913)
and Deed Vol. 126 Page 137 (6-20-1922), Logan County Deed Records.

I hereby certify that this is a true and accurate description of a survey
made by me on May 3, 1975.

Daniel E. Gilbert
Daniel E. Gilbert, P.S.
Reg. Sur. No. 5402
1041 N. Main St.
Bellefontaine, Ohio 43311

INDEXED ON MAP
5775 ID-2

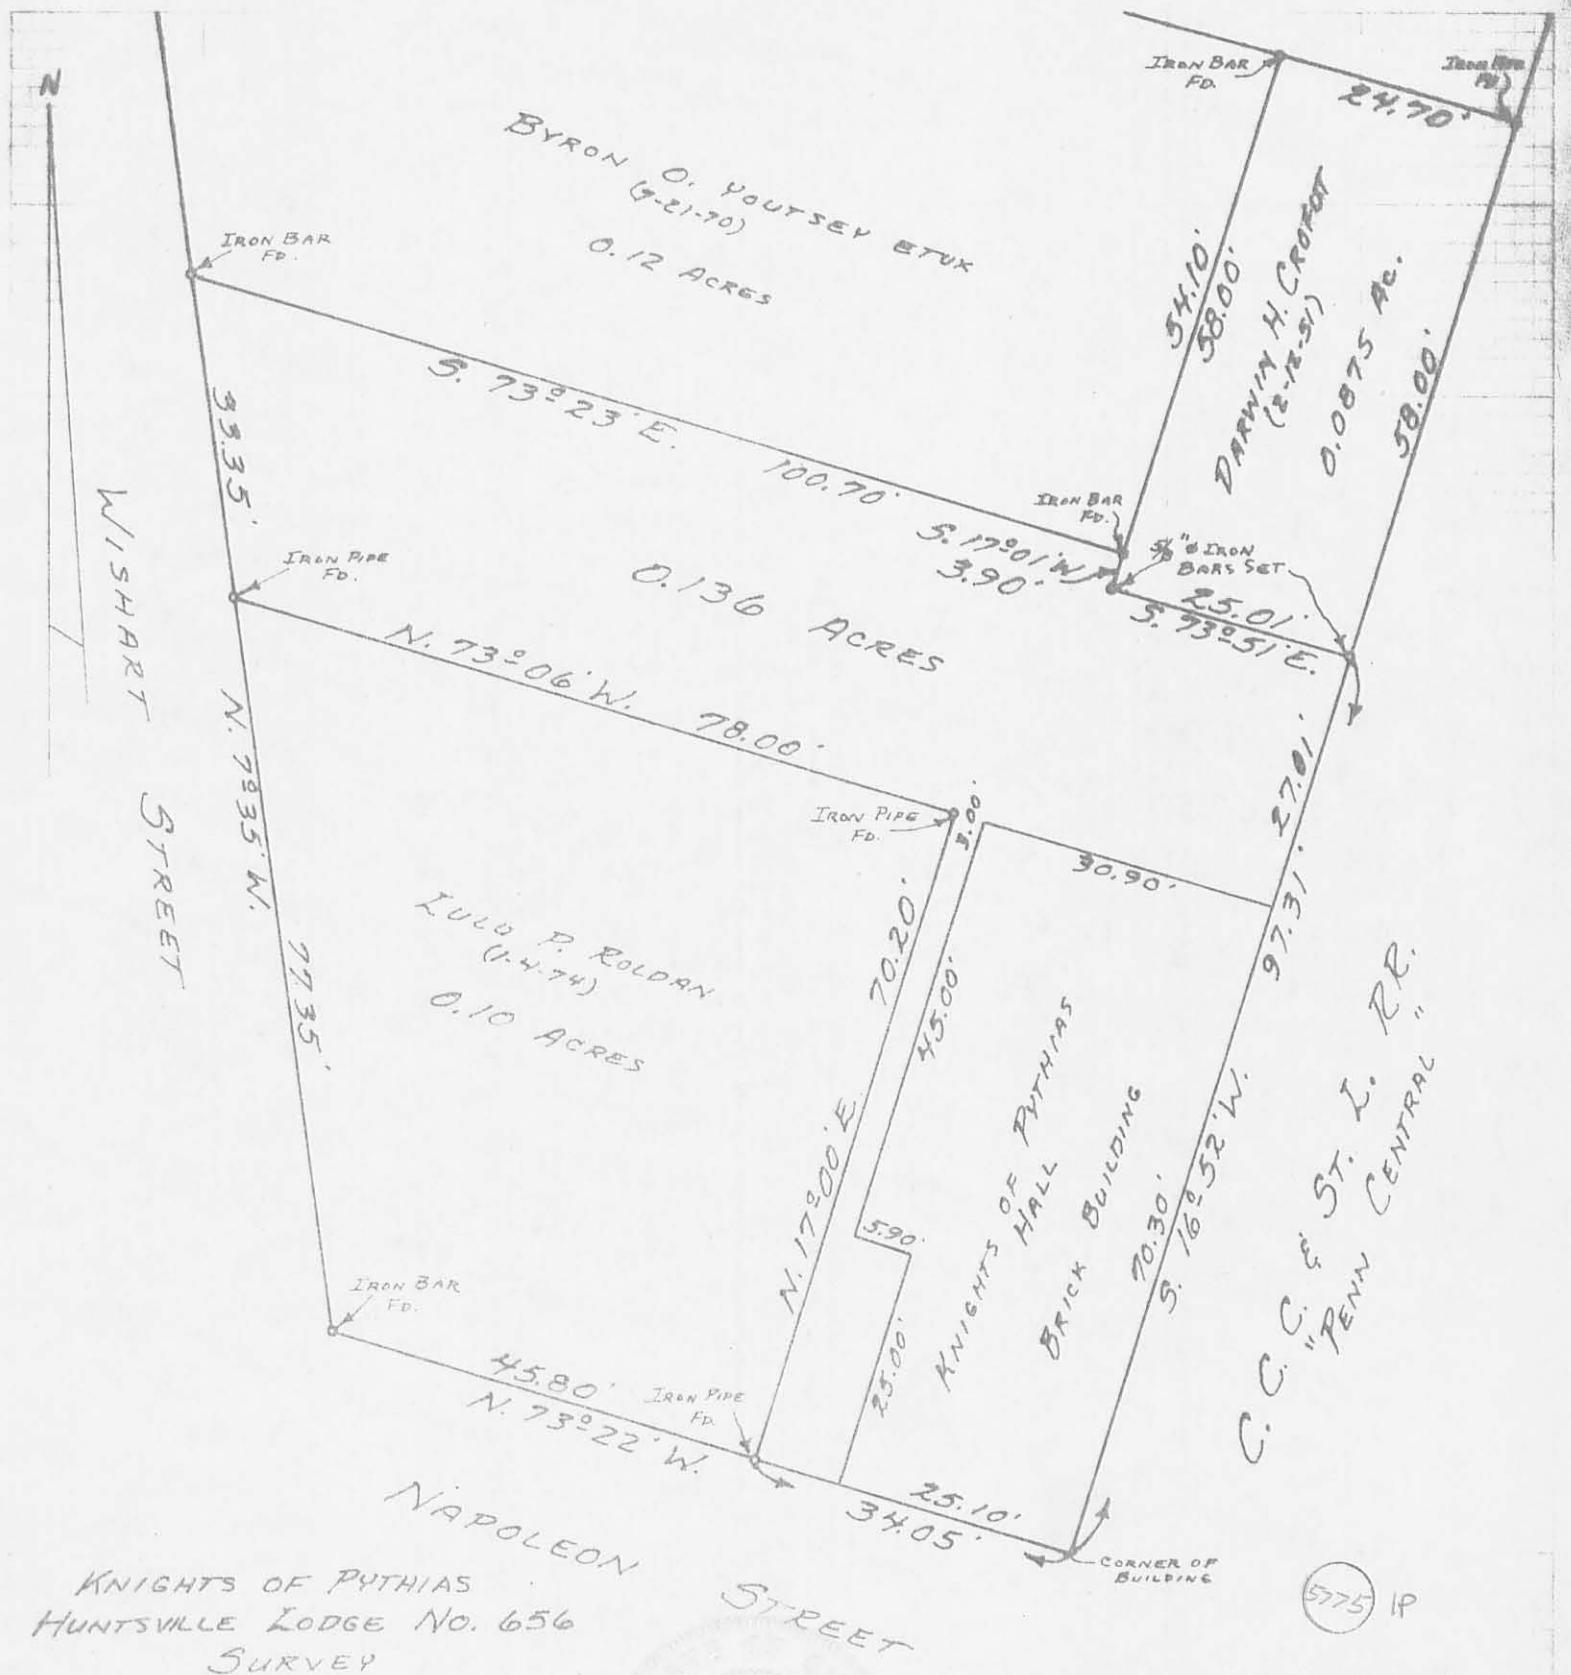

KNIGHTS OF PYTHIAS
HUNTSVILLE LODGE NO. 656
SURVEY

V. M. S No. 9904
VILLAGE OF HUNTSVILLE
M^c.ARTHUR TOWNSHIP
LOGAN COUNTY, OHIO
MAY 3, 1975
SCALE: 1"=20'

INDEXED ON MAP

SURVEYED AND PLATED BY:
DANIEL E. GILBERT, P.S.
REC. SUR. NO. 5402
1041 N. MAIN ST.
BELLEFONTEINE, OHIO 43311