

Lot 52 and Acreage Survey
Huntsville

The following described real estate situated in the Village of Huntsville, Township of McArthur, County of Logan, State of Ohio and being a part of Virginia Military Survey No. 9904 and all of Lot No. 52 and being more particularly described as follows:

Beginning at an iron bar set at the northwest corner to Lot No. 54 (old lot No. 1 of Welsh and Shafer Subdivision as recorded) and in the east line of Fruit Street;

Thence with the east line of Fruit Street, N. $14^{\circ} 00'$ E. 62.073 feet to an iron bar set at the southwest corner to Lot No. 51;

Thence with the south line of Lot No. 51, S. $74^{\circ} 30'$ E. 132.00 feet to an iron bar set at the southeast corner to Lot No. 51 and in the west line of a 15.0 foot alley;


Thence with the west line of said alley, S. $14^{\circ} 00'$ W. 49.00 feet to ^{an iron bar set at} the north-east corner to Lot No. 54, passing the southeast corner to Lot No. 52 at 34.485 feet;


Thence with the north line of Lot No. 54, N. $79^{\circ} 55'$ W. 132.27 feet to the place of beginning, containing 0.168 Acres, more or less.

Of the above described tract, there is 0.148 Acres in Lot No. 52 and 0.02 Acres in V. M. S. No. 9904.

I hereby certify that this is a true and accurate description of a survey made by me on February 27, 1982.

Daniel E. Gilbert
Daniel E. Gilbert, P.S.
Reg. Sur. No. 5402
1041 N. Main St.
Bellefontaine, Ohio 43311

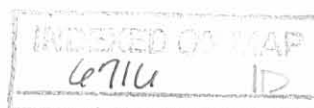

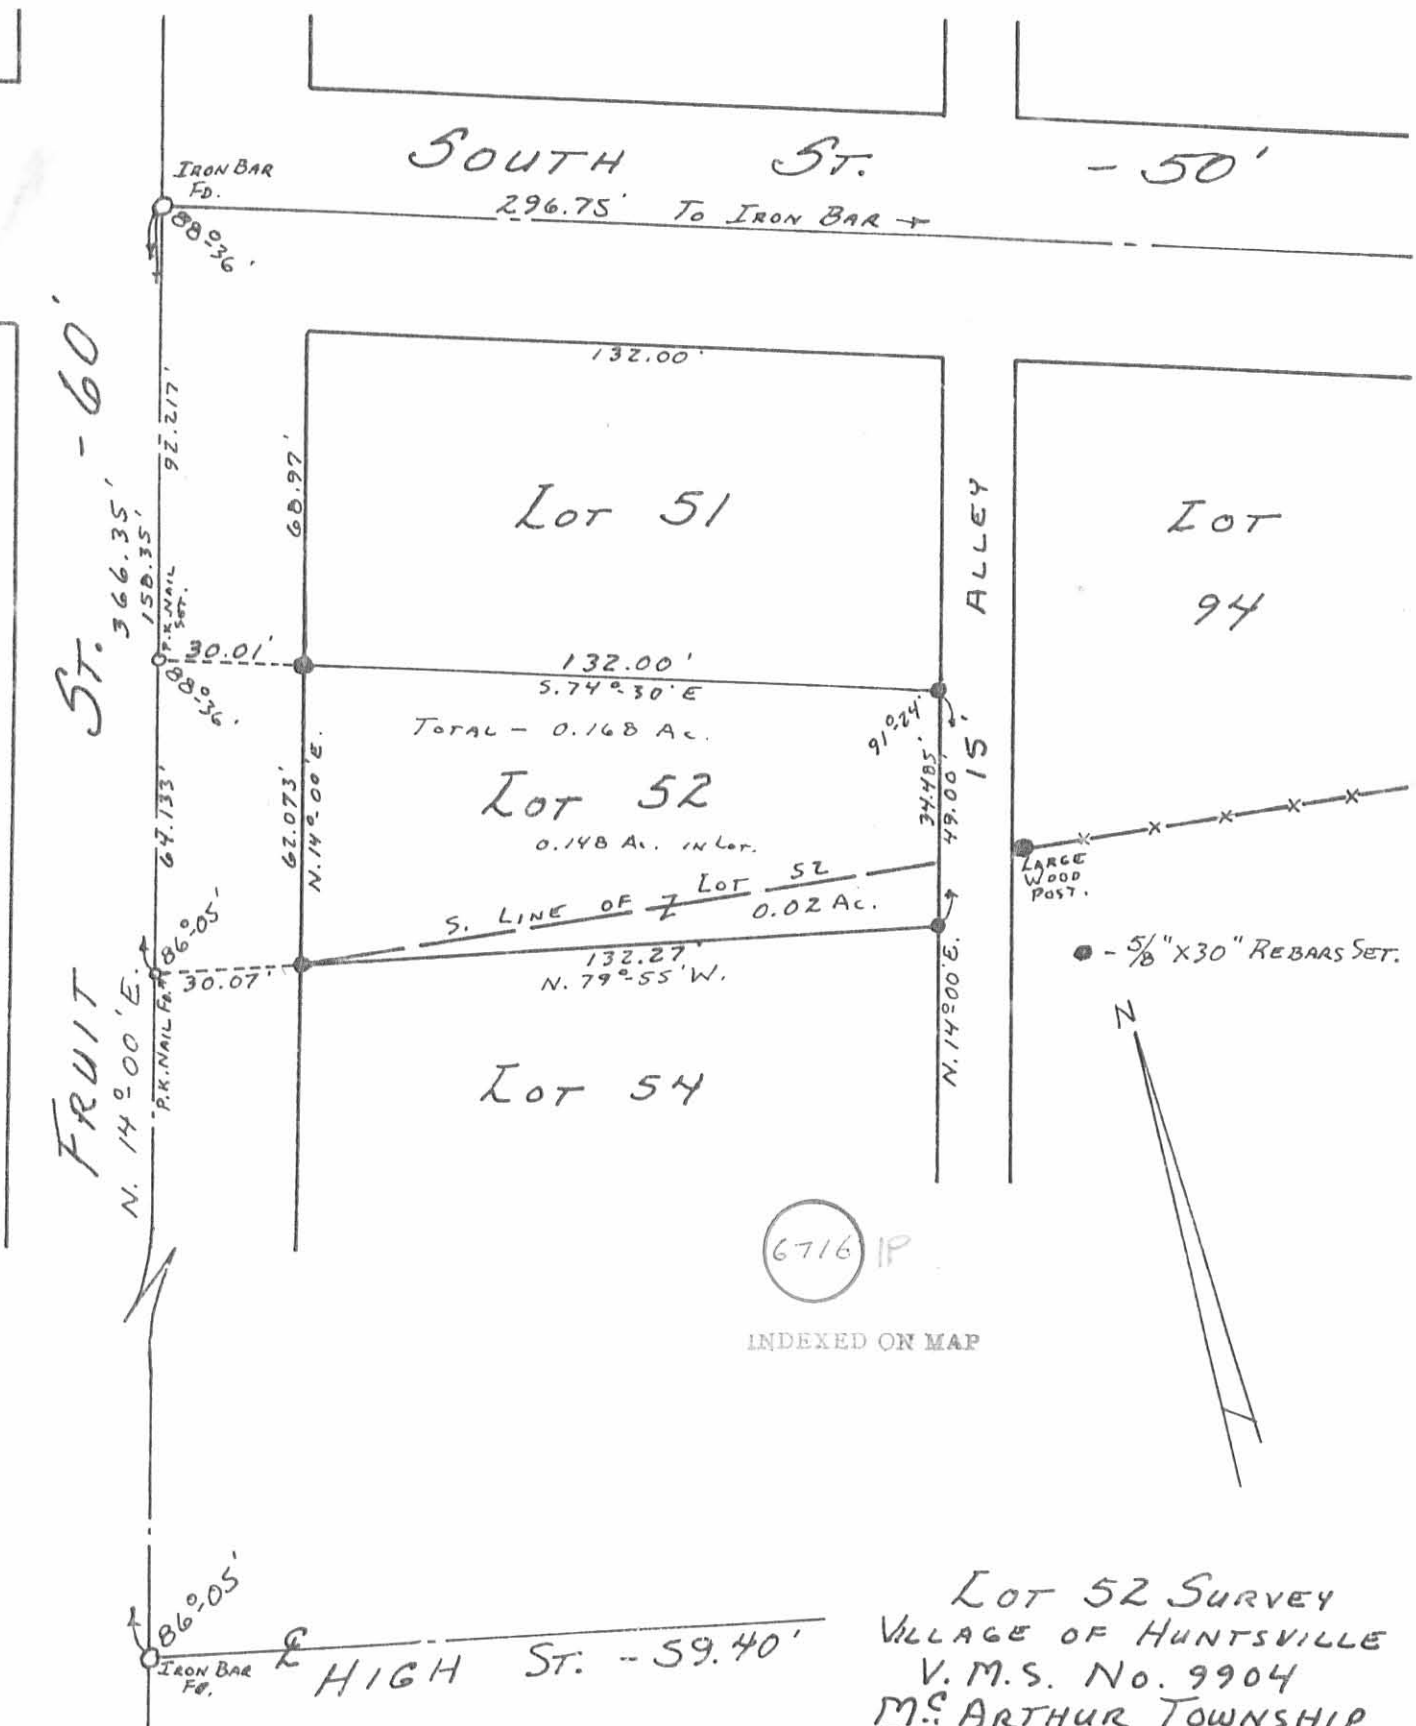

SURVEYED AND PLATTED BY:
 DANIEL E. GILBERT, P.S.
 REG. SUR. No. 5402
 1041 N. MAIN ST.
 BELLEFONTAINE, OHIO 43311

LOT 52 SURVEY
 VILLAGE OF HUNTSVILLE
 V.M.S. No. 9904
 M.C. ARTHUR TOWNSHIP
 LOGAN COUNTY, OHIO
 FEBRUARY 27, 1982

SCALE: 1" = 40'