


John P Whitehill Survey,
 Military Sur. 3441 Jefferson Tp.
 May. 9, 1911.

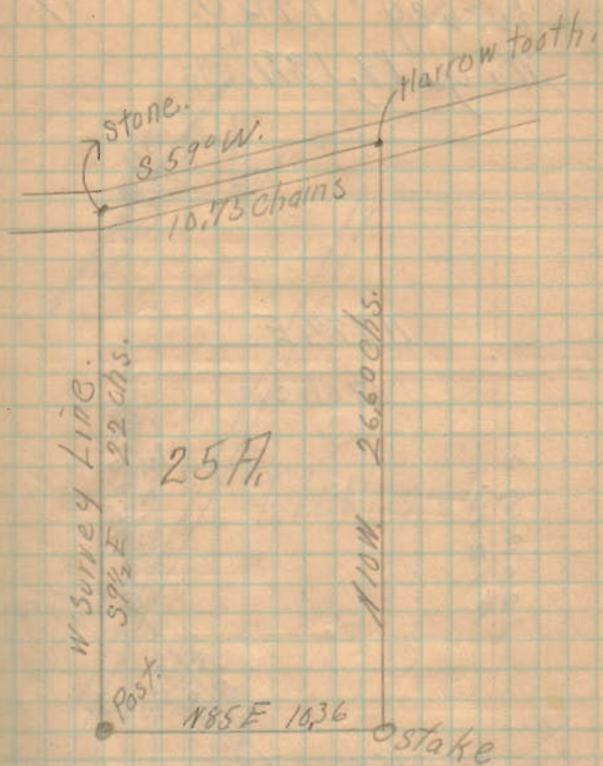

367