


Plat of part of Virginia Military Survey No 3220. Jefferson Tp.  
 Surveyed for Jesse Grubbs. May 13, June 18, July 7, 1890

445  
 INDEXED ON MAP

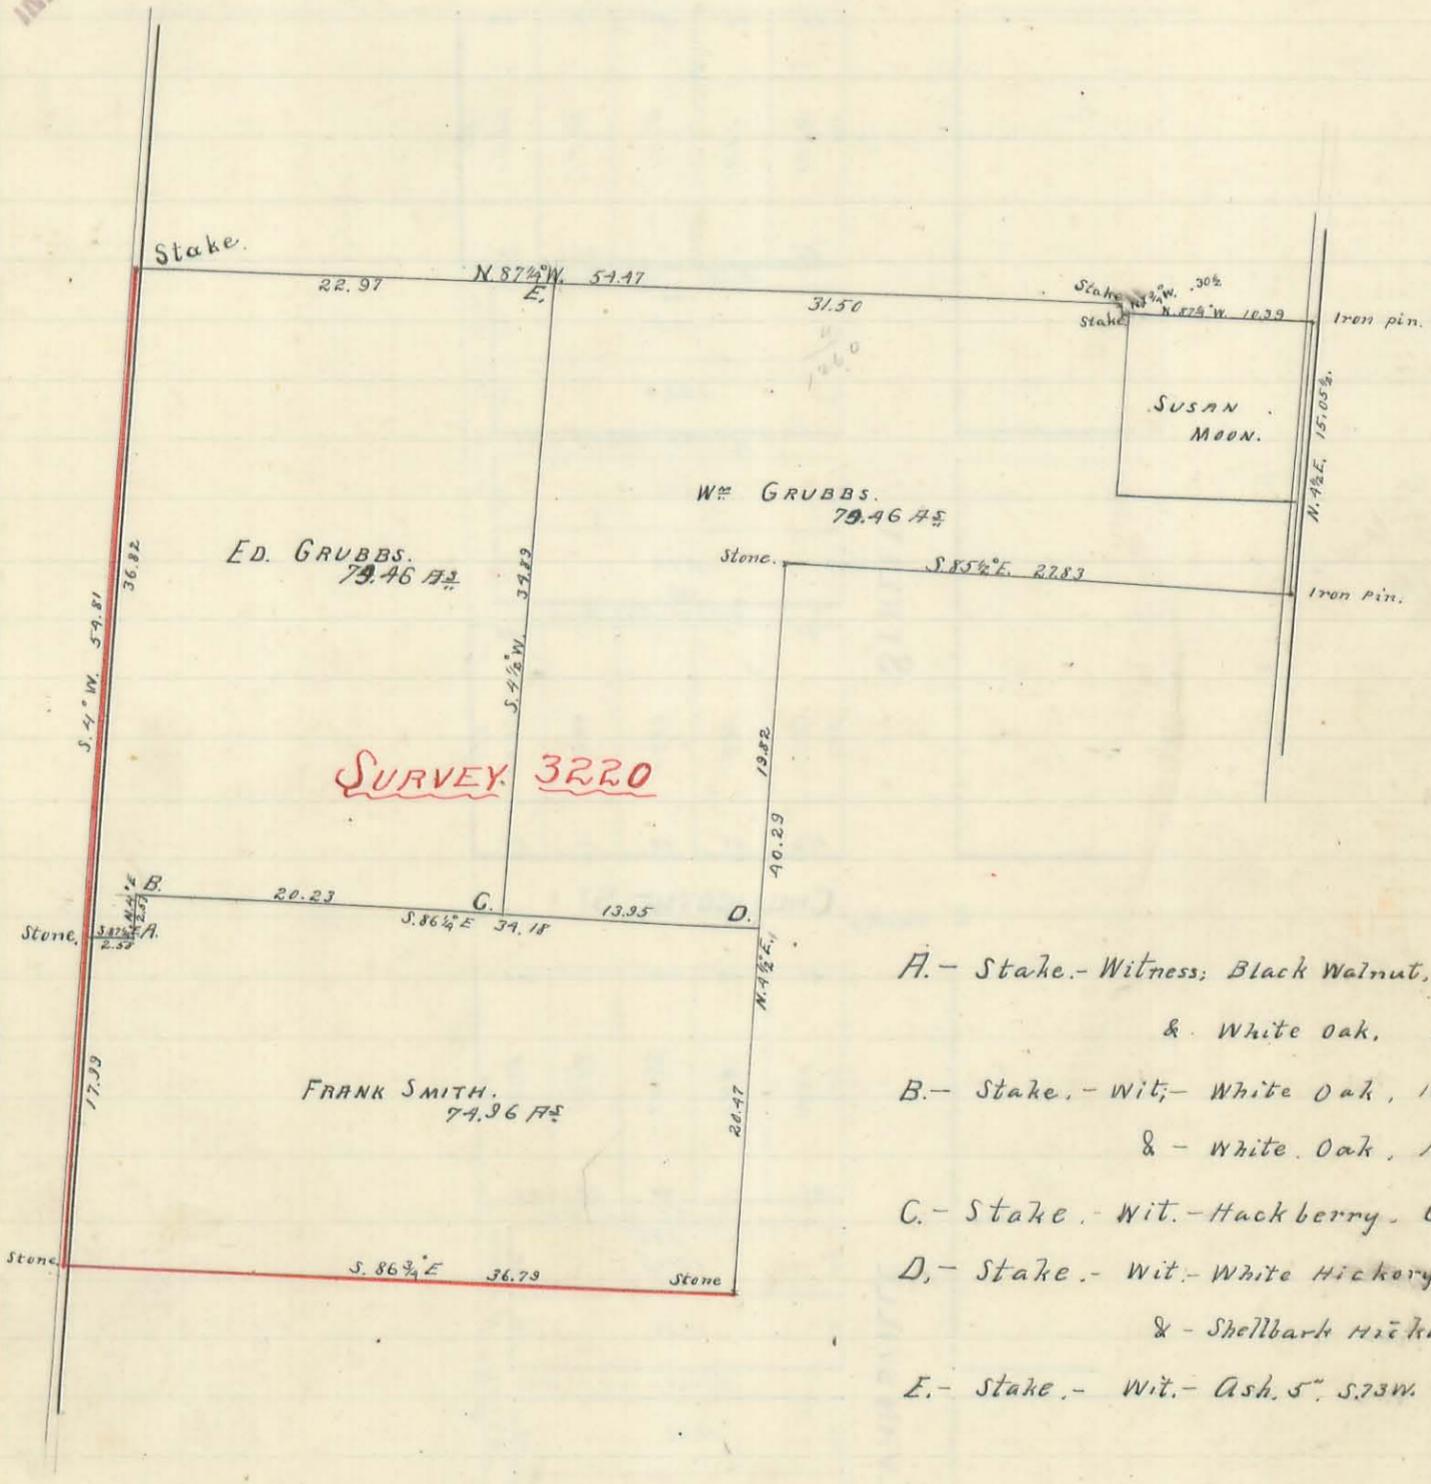

- A. - Stake. - Witness; Black Walnut, 12", S. 53 3/4 E. 33 lks.  
 & White Oak, 10", N. 58 1/2 W. 37 1/2 lks.
- B. - Stake. - Wit. - White Oak, 10", S. 2° W. 95 lks.  
 & - White Oak, 16", S. 20° E. 88 lks.
- C. - Stake. - Wit. - Hackberry, 6", N. 78 3/4 E. 72 lks.
- D. - Stake. - Wit. - White Hickory, 15", N. 56 3/4 W. 37 1/2 lks.  
 & - Shellbark Hickory, 12", N. 29 E. 97 1/2 lks.
- E. - Stake. - Wit. - Ash, 5", S. 73 W. 10 1/2 lks.

Surveyed as shown above  
 Jas. C. Warden  
 County Surveyor