

Miller - Baker Survey Jefferson Township Sept. 1960 0.65 Acre

The following described land in Jefferson Township, Logan County, Ohio and being in V.M.S. 3139

Beginning at an iron in the tangent center line of U.S. Route Number 33 at the N.E. corner of George Daugherty's 100.76 acre tract which is also the S.E. corner of H. Wilson Baker's present 10.13 acre tract.

Thence with the north line of said Daugherty 100.76 acre tract S. 73 - 00 W. 335.00 feet to an iron. The last described line passing the north side of a very large hackberry tree at 37.00 feet.

Thence N. 17 - 00 W. 38.00 feet to an iron in the center of a small creek.

Thence with the center of said small creek N. 52 - 56 E. 146.00 feet to an iron.

Thence again with the center of said small creek N. 38 - 01 E. 120.30 feet to a small iron in the center of a concrete bridge and also being in the center line of U.S. Route Number 33

Thence with the tangent center line of said U.S. Route Number 33 S. 49 - 23 E. 185.15 feet to the place of beginning.

Said described tract containing 0.65 of one acre and being out of the S.E. corner of H. Wilson Baker's present 10.13 acre tract.



cc

Logan County Engineer

ON Plat Book

2842

INDEXED ON MAP

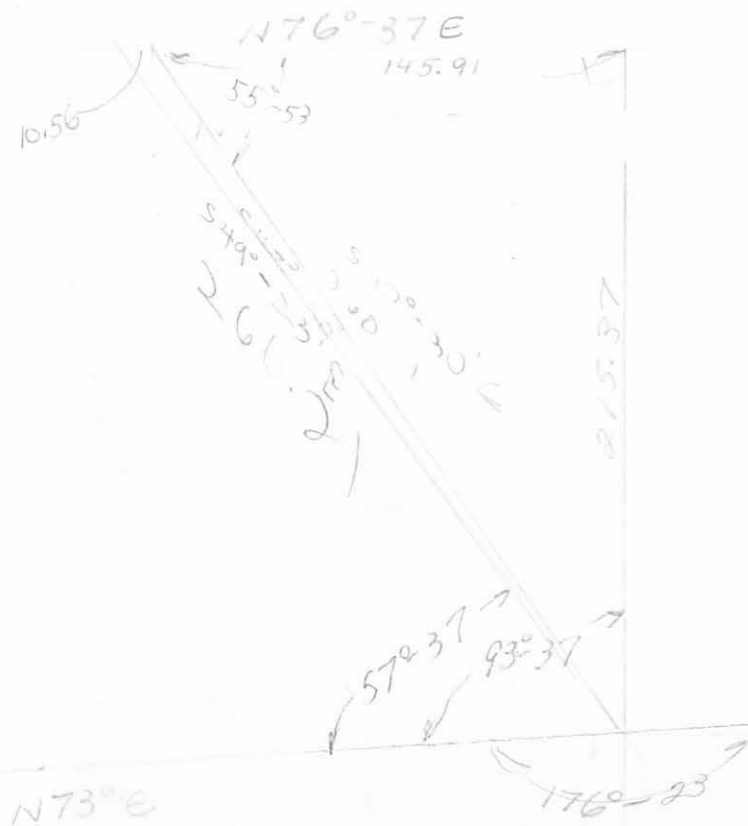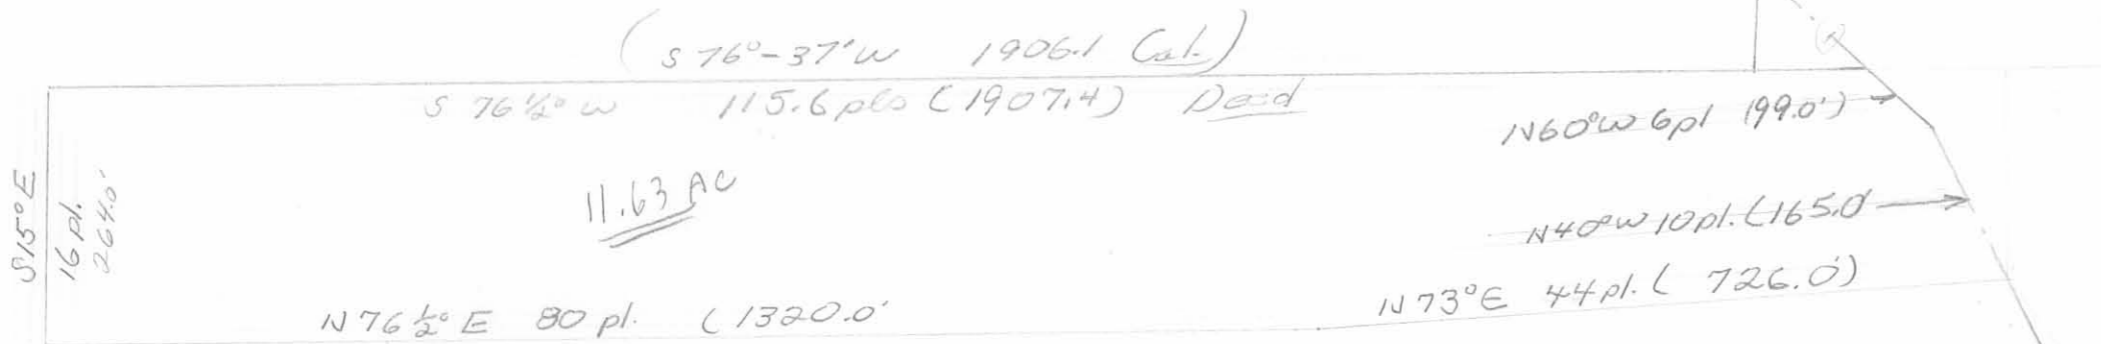

INDEXED ON MAP
 2042 2P