

STATE OF OHIO  
RECEIVED SEP 25 1979  
TIME 1:38 PM  
RECORDED SEP 25 1979  
VOL. NO. 385 PAGE 122-123  
CAROLYN COLLINS  
LOGAN COUNTY RECORDER

COMPARED

G  
5.01


STATE OF OHIO

COUNTY OF FRANKLIN, TO-WIT:

Be it known that on this 21<sup>st</sup> day of SEPTEMBER, 1979  
before me, Theodore R. Wertz, Jr., a Notary Public in and for the county  
and state aforesaid, residing in the City of Columbus, in said  
County, duly commissioned and sworn, and by law authorized to administer oaths  
and affirmations, personally appeared Paul R. Clapsaddle  
and Daniel E. Gilbert, County of Logan  
State of Ohio, and being by me first duly sworn, on his oath  
deposes and says:

An error was made by the undersigned Daniel E. Gilbert and Paul R.  
Clapsaddle in platting Lot 6 of Sunrise Estates as was recorded on the 23rd day  
of November, 1973 in Plat Book 6 F on Page 67.

The plat drawn below indicates the corrected bearings and distances  
for the Southwest and Southeast Lot lines of said Lot 6. (Corrections in  
parenthesis.)

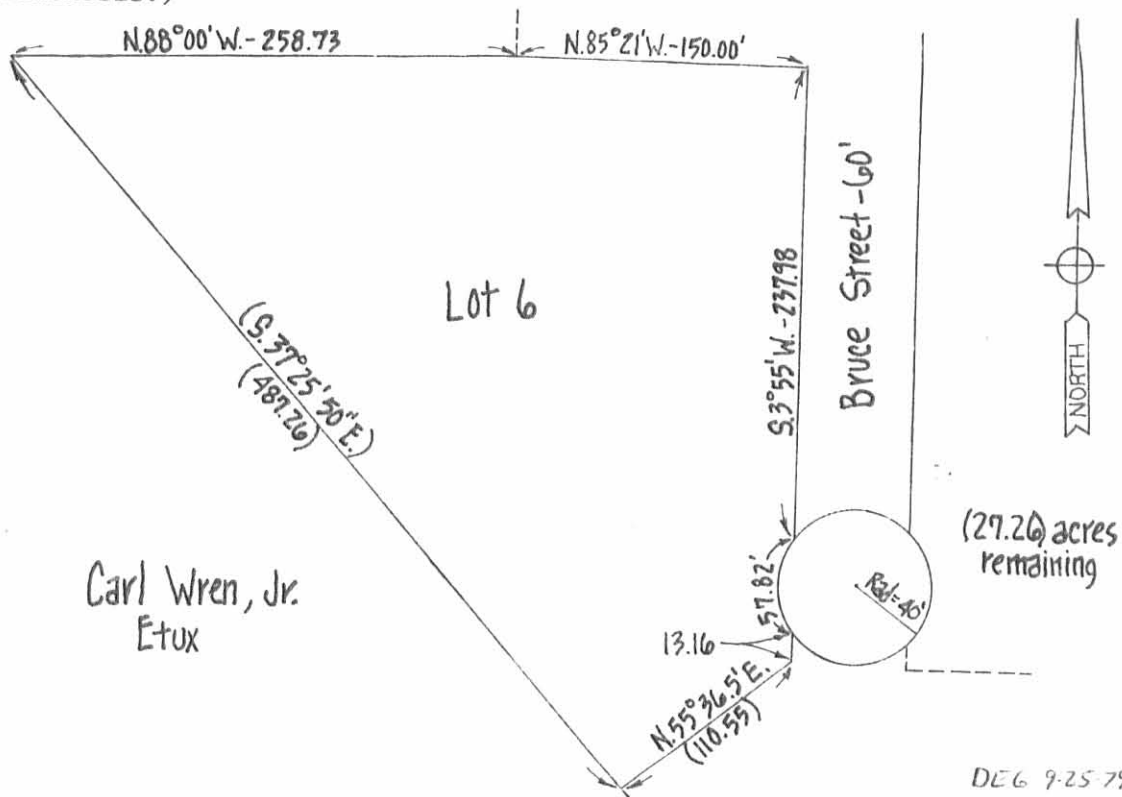

The total Lot acreage indicated on said Plat is 16.59 acres and due  
to the aforesated error, the total Lot acreage should be 16.45 acres.

9-25-79  
TRANSFER NOT NECESSARY  
LOGAN COUNTY AUDITOR  
li


5965 IP

Paul R. Clapsaddle  
AFFIANT

Daniel E. Gilbert  
AFFIANT

INDEXED ON MAP

MAP OFFICE

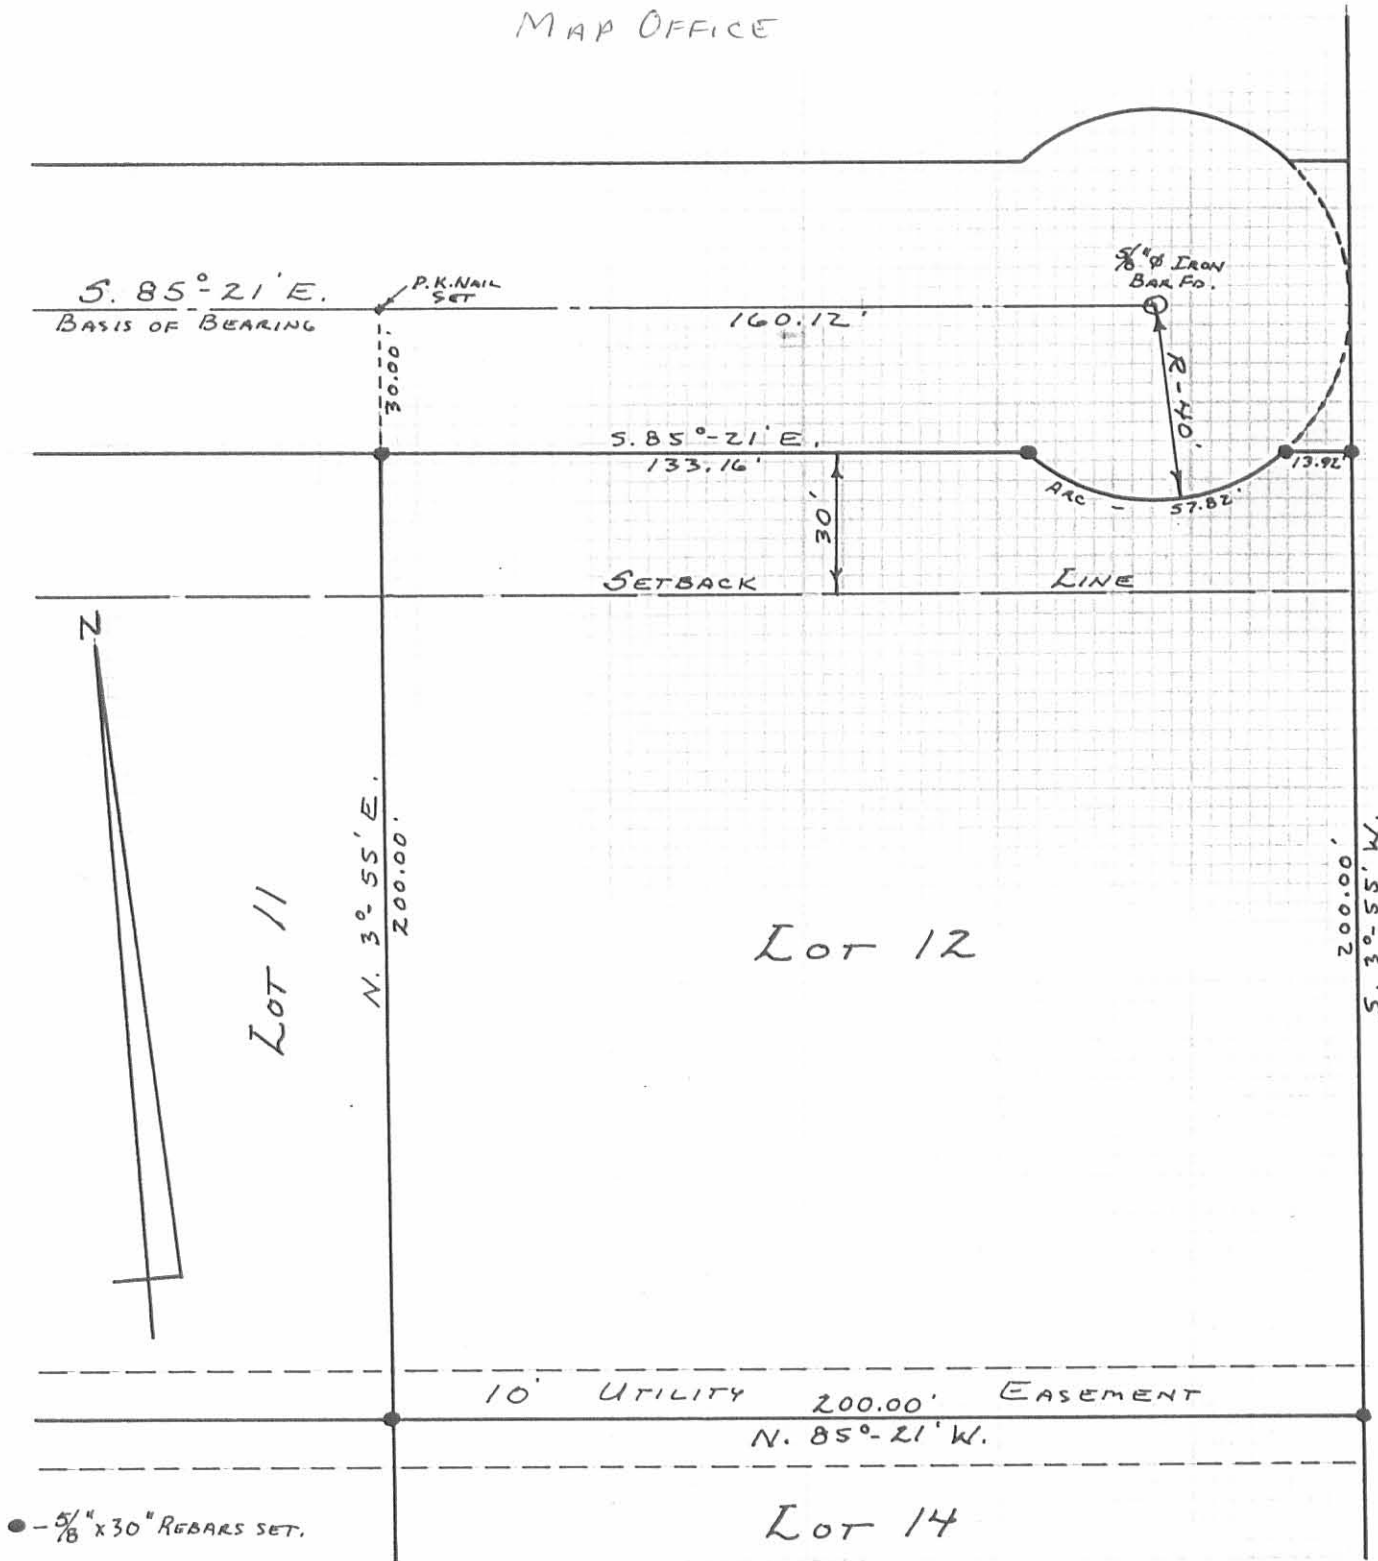

INDEXED ON MAP  
5965 2P



Daniel E. Gilbert  
 DANIEL E. GILBERT, P.S.  
 REG. SUR. No. 5402  
 400 N. PARK ST.  
 BELLEFONTAINE, OHIO  
 43311

RESURVEY OF LOT 12  
 SUNRISE ESTATES  
 V.M.S. No. 4477  
 JEFFERSON TOWNSHIP  
 LOGAN COUNTY, OHIO  
 MAY 11, 1988

SCALE: 1" = 40'