


FB 708

T.R. 145
 JEFFERSON TOWNSHIP
 V.M.S. 9371-12174

Survey to locate E of unused
 portion of T.R. 145 from St. 51+67.98
 to St. 57+60.62


Used 3/4" pipe @ 51+67.98 (See Drawer E 2873
 for Smith-Campbell Survey) and split of
 old fences to establish E from 51+67.98
 to 57+60.62

Searched for Man's
 Plan L-40 @ 1266+00-
 1256+00- 1246+00
 Did not find any

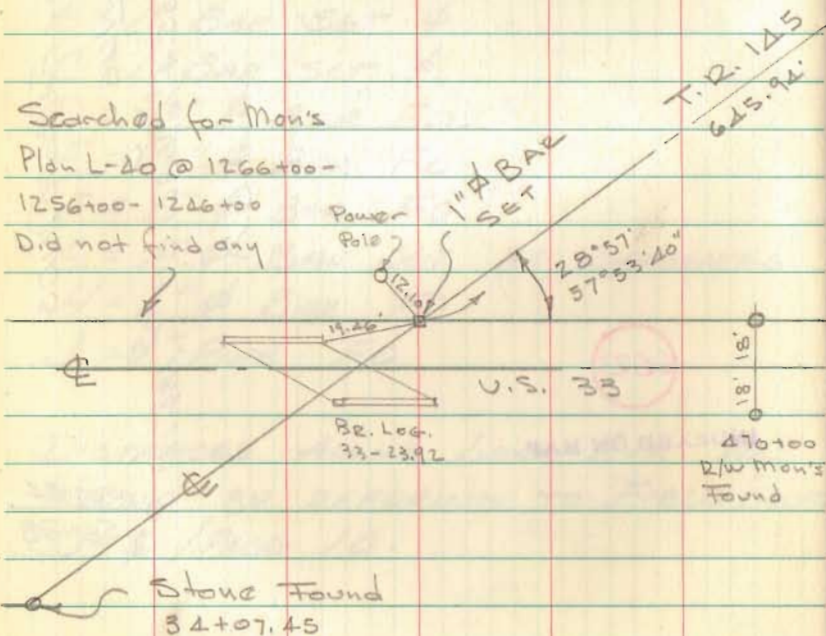

8/18/71
 D. Dodson
 D. Brooks
 J. Souds
 J. Zupp
 D. Dodson Jr.

8/19/71 - 8/20/71
 C. Nichols - D. Brooks 20
 J. Souds - D. Zupp - D. Dodson Jr.

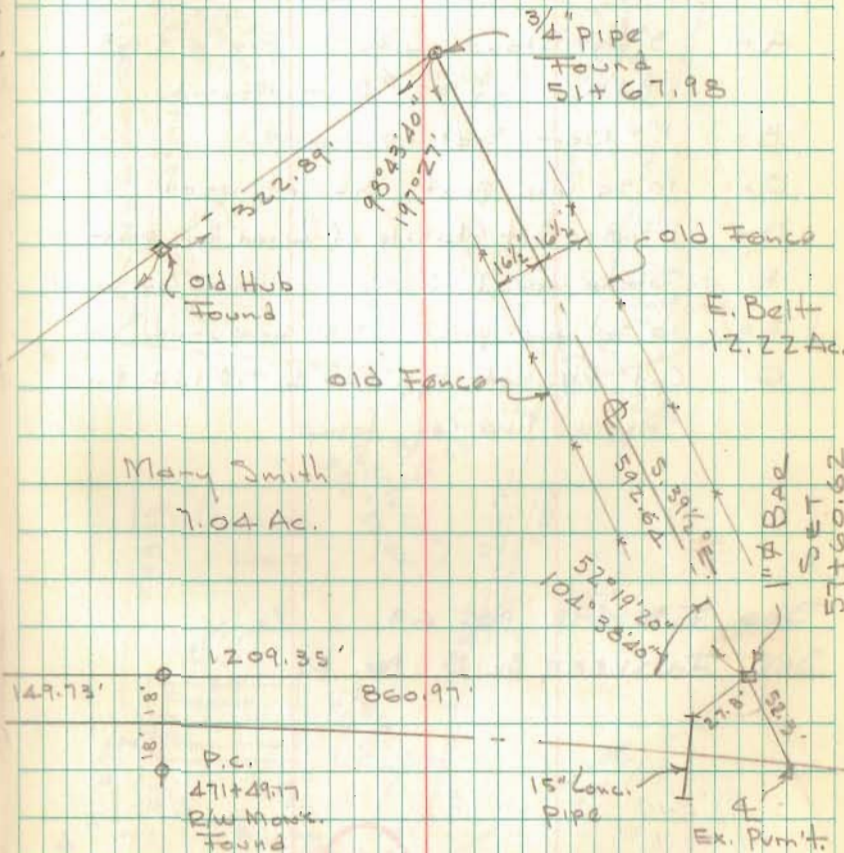

See Plan L-45 for 6674
 E U.S. 33

INDEXED ON MAP