


BRAYTON COONS DESCRIPTION

The following real estate situated in the State of Ohio, County of Logan, and in the Township of Jefferson and in the Hillwood Allotment in V.M.S. 3220, and being Lot seven (7), and 70 feet off the south side of Lot six (6) of said allotment as shown on the recorded plat of said allotment.

7204 1D

INDEXED ON MAP

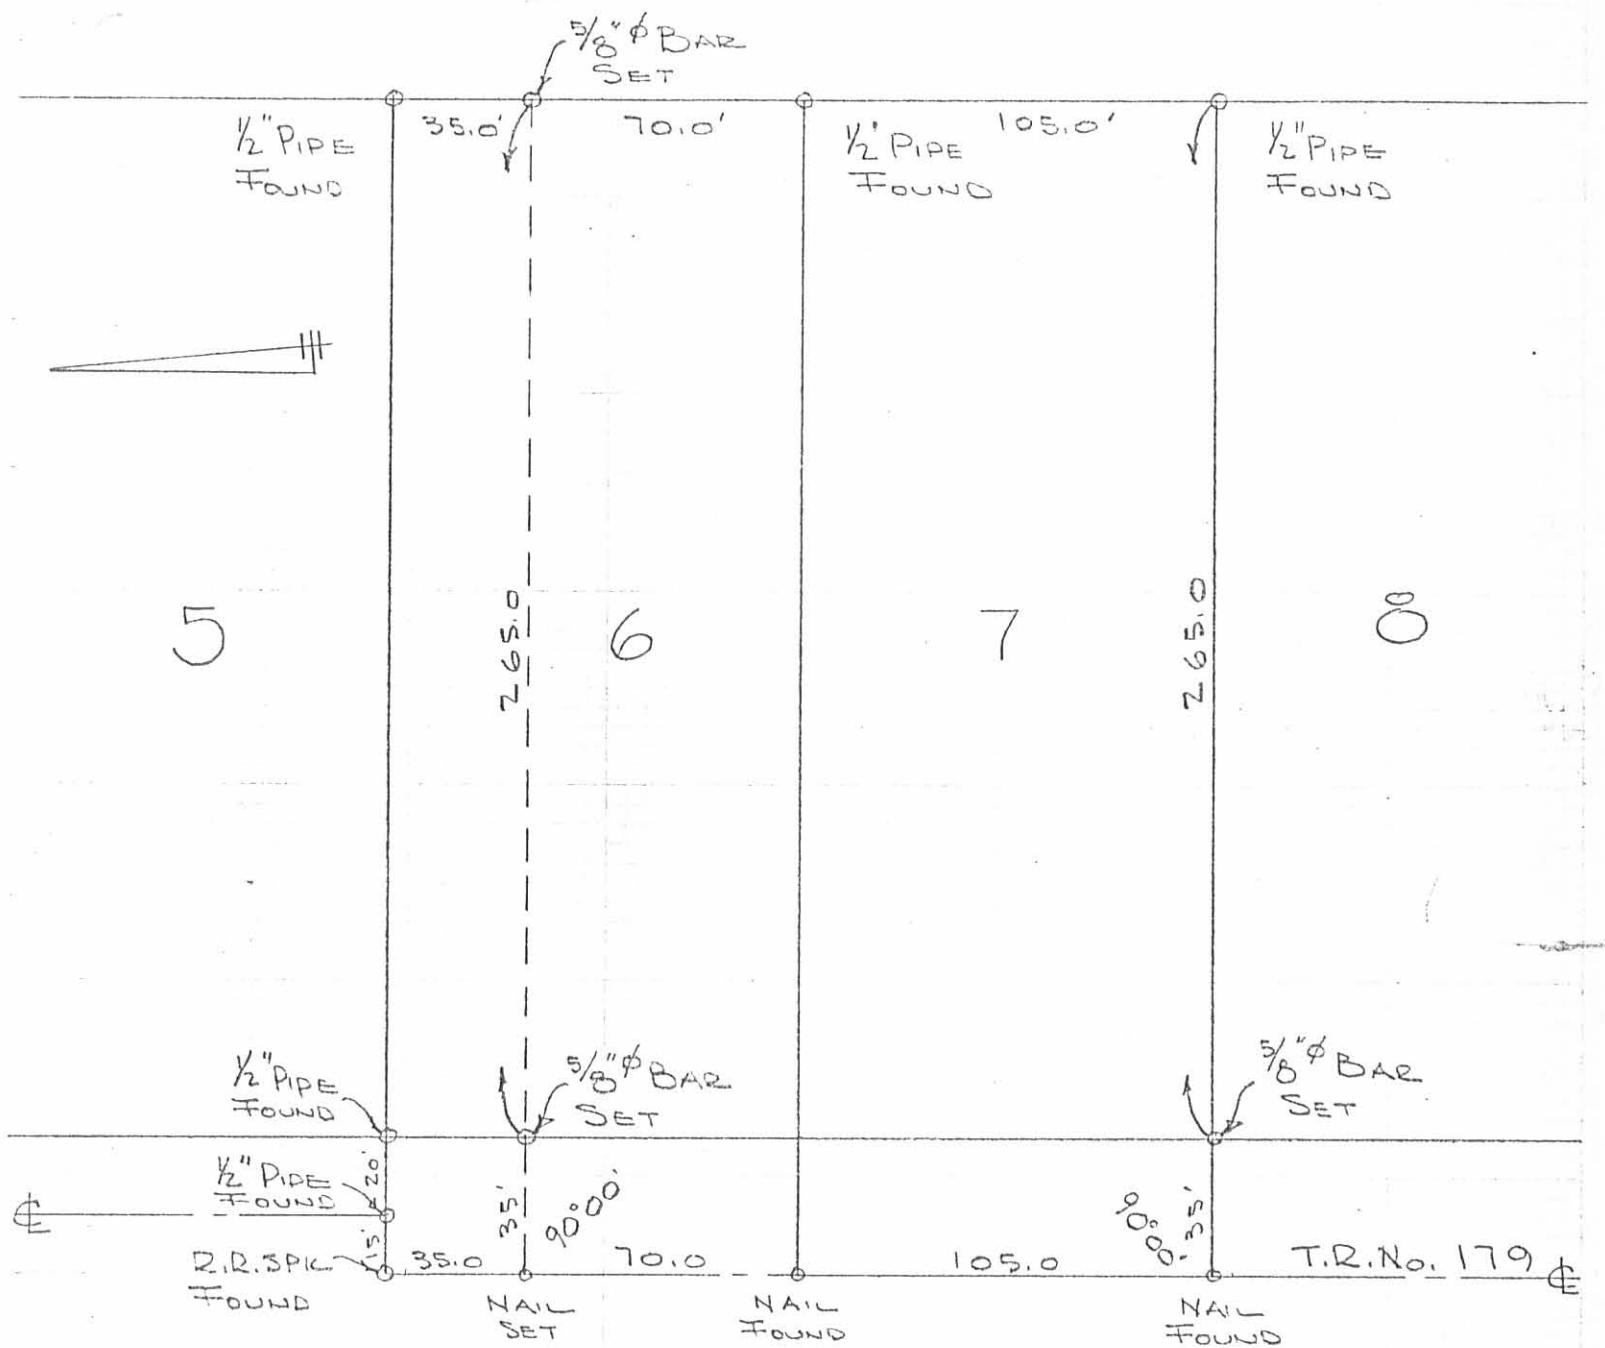

SURVEY OF LOT 7 & 6 PT.
 HILLWOOD ALLOTMENT
 V.M.S. 3220
 JEFFERSON TOWNSHIP
 LOGAN COUNTY, OHIO
 JUNE 8, 1969
 SCALE 1" = 50'

DAN L. DODSON
 REG. SURVEYOR 4210
 BELLEFONTAINE, O.

(7204) IP

INDEXED ON MAP