


6th June 16th 1828

Survey No. 105

Surveyed for William Dixon

8224

Beginning at 2 small white oaks cherry tree bush and ash in the east line of fractional section 15 Town. 2 Range 14 N.R.S. South east corner to James Moore's land - Thence $\text{S} 44^{\circ} \text{E}$ 175 poles to a white oak, mulberry tree and ironwood thence $\text{E} 34^{\circ} \text{W}$ 72 poles to a huckleberry and bur oak on the east bank of the Great Miami river, south west corner to said Moore's land - Thence down the river with its meanders to a large red oak, 2 buckeyes and small beech, corner between William and Thompson Dixon - Thence $\text{N} 44^{\circ} \text{E}$ 134 poles to a large white oak thence $\text{S} 37^{\circ} \text{E}$ 67 poles to a black oak and red bud and ash in the east line of said fraction
 Thence with said line north 76 poles to the beginning containing my $\frac{1}{4}$ acres of said fractional section & John Dixon, Thompson Dixon }
 John Dixon, Thompson Dixon }

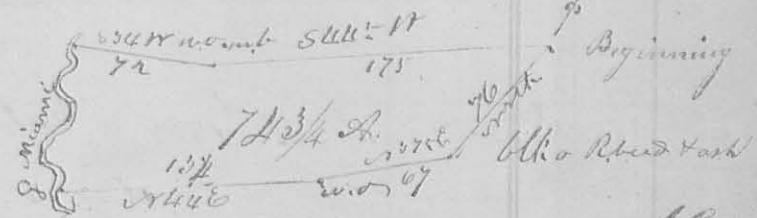


J. Waller now 1/4

6th June 17th 1828

Survey No. 116

Surveyed for Thompson Dixon

Beginning at a black oak, red bud, and ash in the east line of fractional section 15 Town. 2 Range 14 N.R.S. corner to William Dixon's land, thence $\text{S} 37^{\circ} \text{W}$ 64 poles to a large white oak, in a road - thence $\text{W} 44^{\circ} \text{W}$ 134 poles to 2 buckeyes, small beech, and large red oak on the east bank of the Miami River, south east corner to William Dixon's land, thence down the river with its meanders to a large cluster of maples growing from one root on the east side of the river thence $\text{N} 33^{\circ} \text{E}$ 195 poles to a stake thence $\text{N} 35^{\circ} \text{W}$ 86 poles

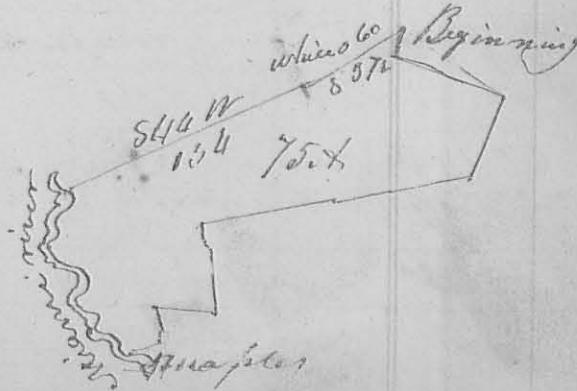

83

45 There is $367^{\circ} N 31.8$ poles to a stake south of an orchard, thence $127^{\circ} W 50$ poles to a stone, thence $174^{\circ} N 7.8$ poles to a stake, thence $128^{\circ} W 8.2$ poles to a stake in the lane and road from Bellefontaine to Sydney, thence with said road $N 55^{\circ} E$ 71 $\frac{1}{2}$ poles to a stake in the east line of said fraction, thence $160^{\circ} E 69$ poles to a stake, thence north 46 poles to 2 white oaks, thence west 63 poles to a stake in the east line of said fraction, thence north with said line 19 poles to the beginning, containing 1 $\frac{1}{2}$ acres, $\frac{3}{4}$ of which are in the south west quarter of sec. 9 Town 2 Range 14 M.M.R.S.

William Dixon
John Dixon

J. W. Thompson J.L.C.

(874) 6th mo. (June) 17th 1828,

Surveyor

107

Surveyed $\frac{1}{2}$ acres of land for said Dixon beginning at a bottom oak on the east bank of the Miami River corner to fractional sec. 10 Town 2 Range 14 M.M.R.S. Thence north 89 poles to the corner between sec. 8, 9 & 10 & 15 thence east 62 poles to a stake thence north 116 poles to a stake thence $160^{\circ} W 69$ poles to a stake in the road from Bellefontaine to Sydney and in the east line of fractional sec. 15, thence with the road $155\frac{1}{2}^{\circ} W 71\frac{1}{2}$ poles to a stake thence $128^{\circ} E 8.2$ poles to a stake, thence $147^{\circ} E 78$ poles to a stone, thence $127^{\circ} E 50$ poles to a stone, thence $167^{\circ} E 31.8$ poles to a stake south of an orchard, thence $131^{\circ} E 10$ poles to a stake thence $143^{\circ} W$ to a stake on the river bank. thence with the meanders of the river to the beginning containing $\frac{1}{2}$ acre, $\frac{3}{4}$ of which are in sec 10 & 15 the remaining $\frac{1}{4}$ are in sec 9 M.M.R.S.

Wm. Dixon
Thompson Dixon J.L.C.