

Road. 246
Lake Twp.

No road width found.

Stakes placed 20' from & at
stations shown.


5-7-9-11-13-15

1531

INDEXED ON MAP

Jan. 3, 1934
cont on ground
Wright
Ed. Corp.

58

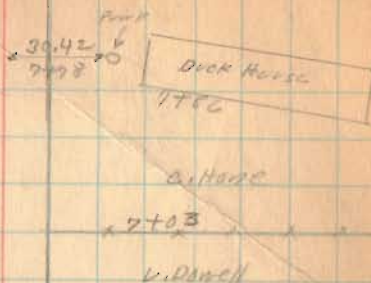

x x 1426

1. Pin with Measurement Corp
at N end of street corner

← To Kenton

S.H. 226
U.S. Route 68

223.7'

Road. 246

1531

INDEXED ON MAP

59

