

KENNEDY SURVEY

V. M. S. 9884
Lake Township
Logan County, Ohio
March 23, 1957

The following described real estate situated in Lake Township, Logan County, Ohio and being part of Virginia Military Survey No. 9884 and more particularly described as follows:

Beginning at an iron pin in the center of County Highway No. 57 at the northwest corner of John G. Kennedy's 44.70 acre tract, said iron pin being Sta. 136+90 as shown in the Logan County Engineer's field book No. 598, page 71; thence with the center line of said County Highway No. 57 N. 84°-30' E. 500.0 feet to an iron pin; thence S. 5°-30' E. 200.0 feet to an iron pin, passing an iron pin at 25.0 feet; thence S. 84°-30' W. 500.0 feet to an iron pin in the west line of said 44.70 acre tract; thence with said west line N. 5°-30' W. 200.0 feet to the place of beginning, passing a stake at 175.0 feet.

Containing 2.30 acres more or less.

on Plat

2956

ID

Kennedy Survey


Henry Dowden

R.R. #2

Bellefontaine, O

Mar. 22, 1957

4

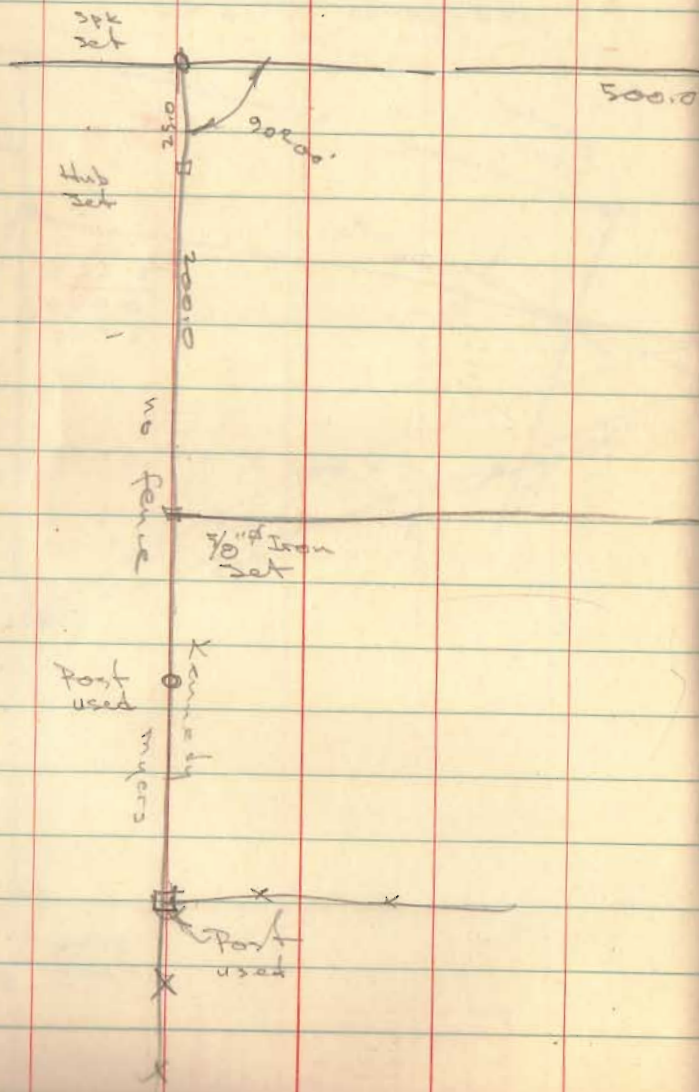

N. 84 1/2 E.

R.H. 3PK set

C.H. 57



	2.25
43560	100,000
	87120
	128800
	87120
	81680

INDEXED ON MAP
2956