



HOLLY HILL SUB

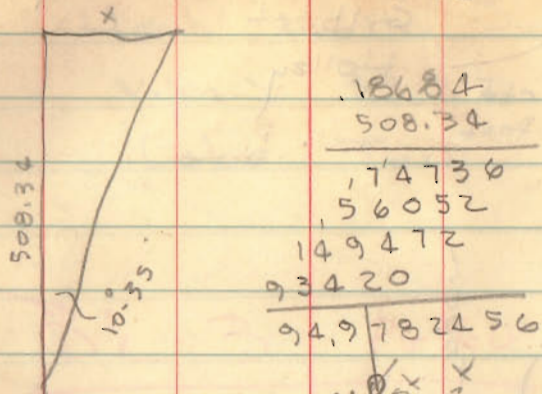

$$\begin{array}{r} 18684 \\ 508.34 \\ \hline 174736 \\ 56052 \\ 149472 \\ 93420 \\ \hline 949782456 \end{array}$$

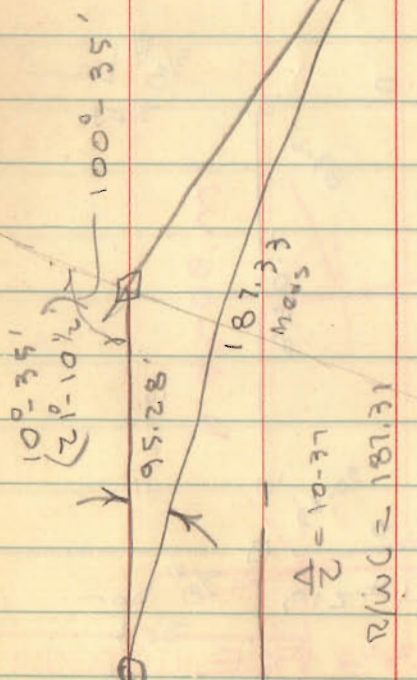

$\Delta = 21^{\circ} - 10'$

$$\begin{array}{r} 90 - 00 \\ 10 - 35 \\ \hline 100 - 35 \end{array}$$

$$\begin{array}{r} 89 - 60 \\ 10 - 35 \\ \hline 79 - 25 \end{array}$$


$$\begin{array}{r} 179 - 60 \\ 79 - 25 \\ \hline 100 - 35 \end{array}$$

$\Delta = 10 - 37$


R/WC = 187.31

INDEXED ON MAP  
3759

Aug. 1, 1959  
Dodson - Geaslin  
Gilbert

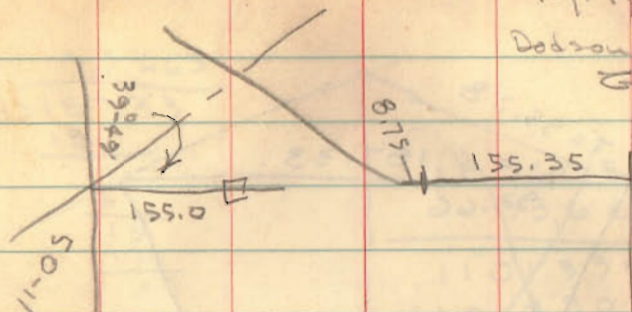


$$\begin{array}{r} 179 - 60 \\ 50 - 11 \\ \hline 129 - 49 \\ 90 \\ \hline 39 - 49 \end{array}$$

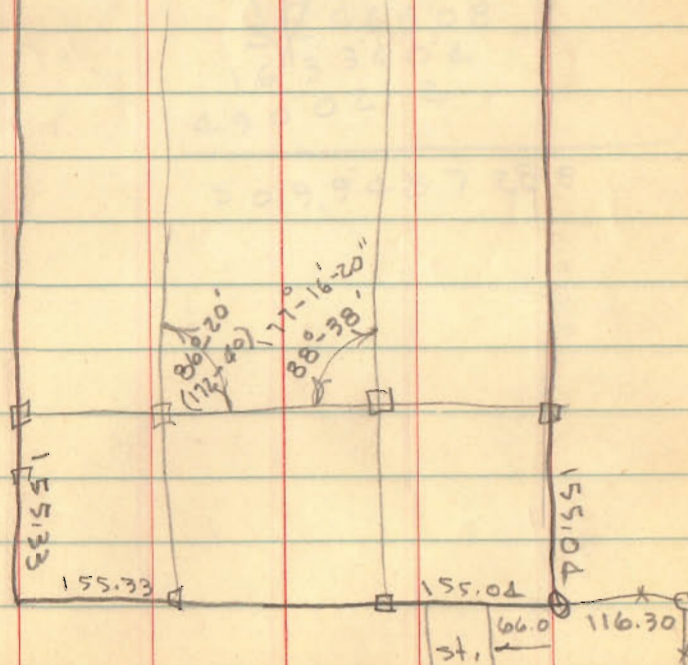

$$\begin{array}{r} 155.04 \\ 66.0 \\ \hline 116.30 \end{array}$$

Holly Hill  
STREET CENTERS

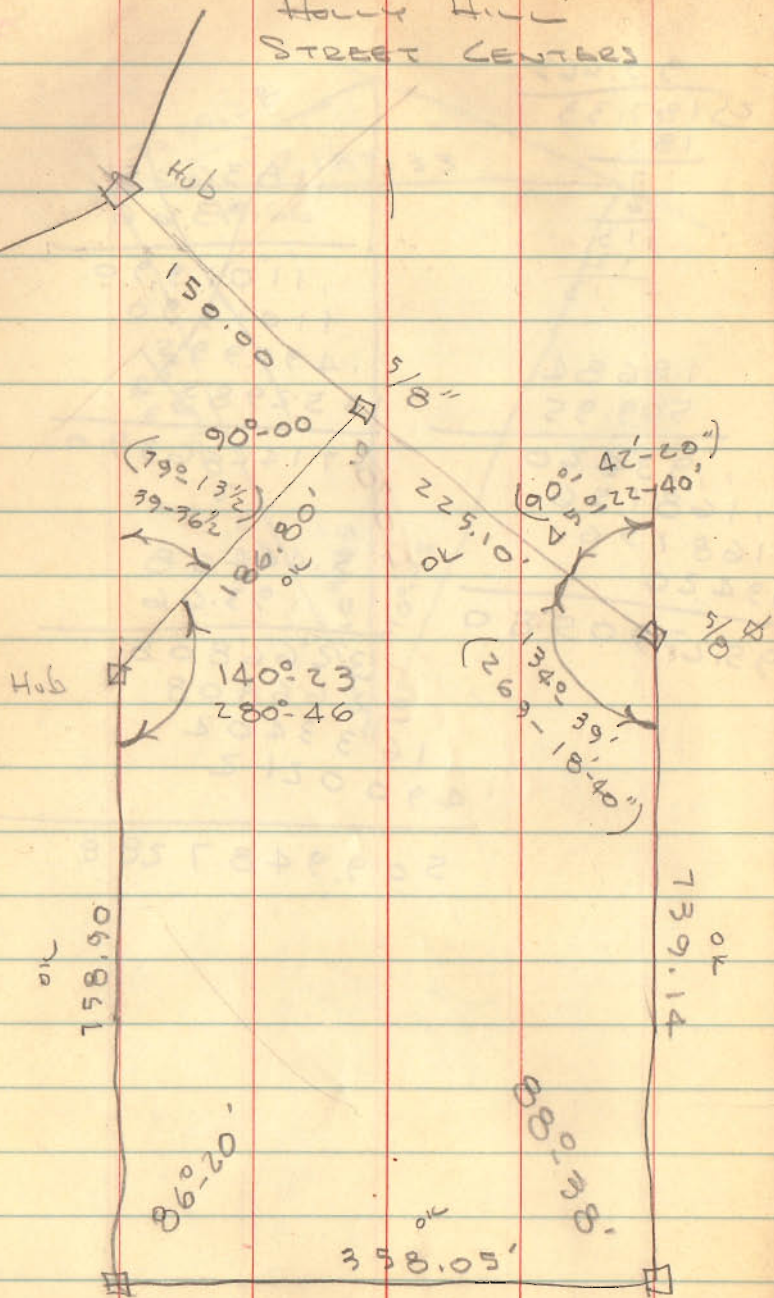

179-60  
174-39  

---

45-21

180  

---

54

3	2
140-23	
90-00	
134-39	
88-38	
86-20	
<hr/>	
538-120	OK

INDEXED ON MAP  
3759