

Forest Jacob's Survey Description

August, 1971

Being situated in Lake Township, Logan County, Ohio; and being a part of V.M.S. #3317.

Beginning at a concrete right of way monument in the south right of way line of State Route 47 that is known as Station 801 + 36.66.

Thence with said south right of way line of State Route 47 S $75^{\circ} - 11'W$ 261.9 feet to a iron in the north line of Boyer's 2.43 acre tract.

Thence with the north line of Boyer's 2.43 acre tract S $69^{\circ} - 11'E$ 283.6 feet to a nail in the center of County Road 9, passing thru a iron at 243.0 feet.

Thence with the center of County Road 9 N $33^{\circ} - 28'E$ 218.1 feet to the point of intersection of the center of County Road 9 with the south right of way line of State Route 47.

Thence with the south right of way line of State Route 47 S $83^{\circ} - 53'W$ 133.0 feet to the place of beginning.

Containing 0.79 of an acre more or less.

Owen K. Shirk

Surveyor 4271

MAILED ON MAP

ID


4882

Forest Jacobs Surveyor

Lake Twp., Logan Co., Ohio, U.S. 33177

1" = 40'

• Denotes corners

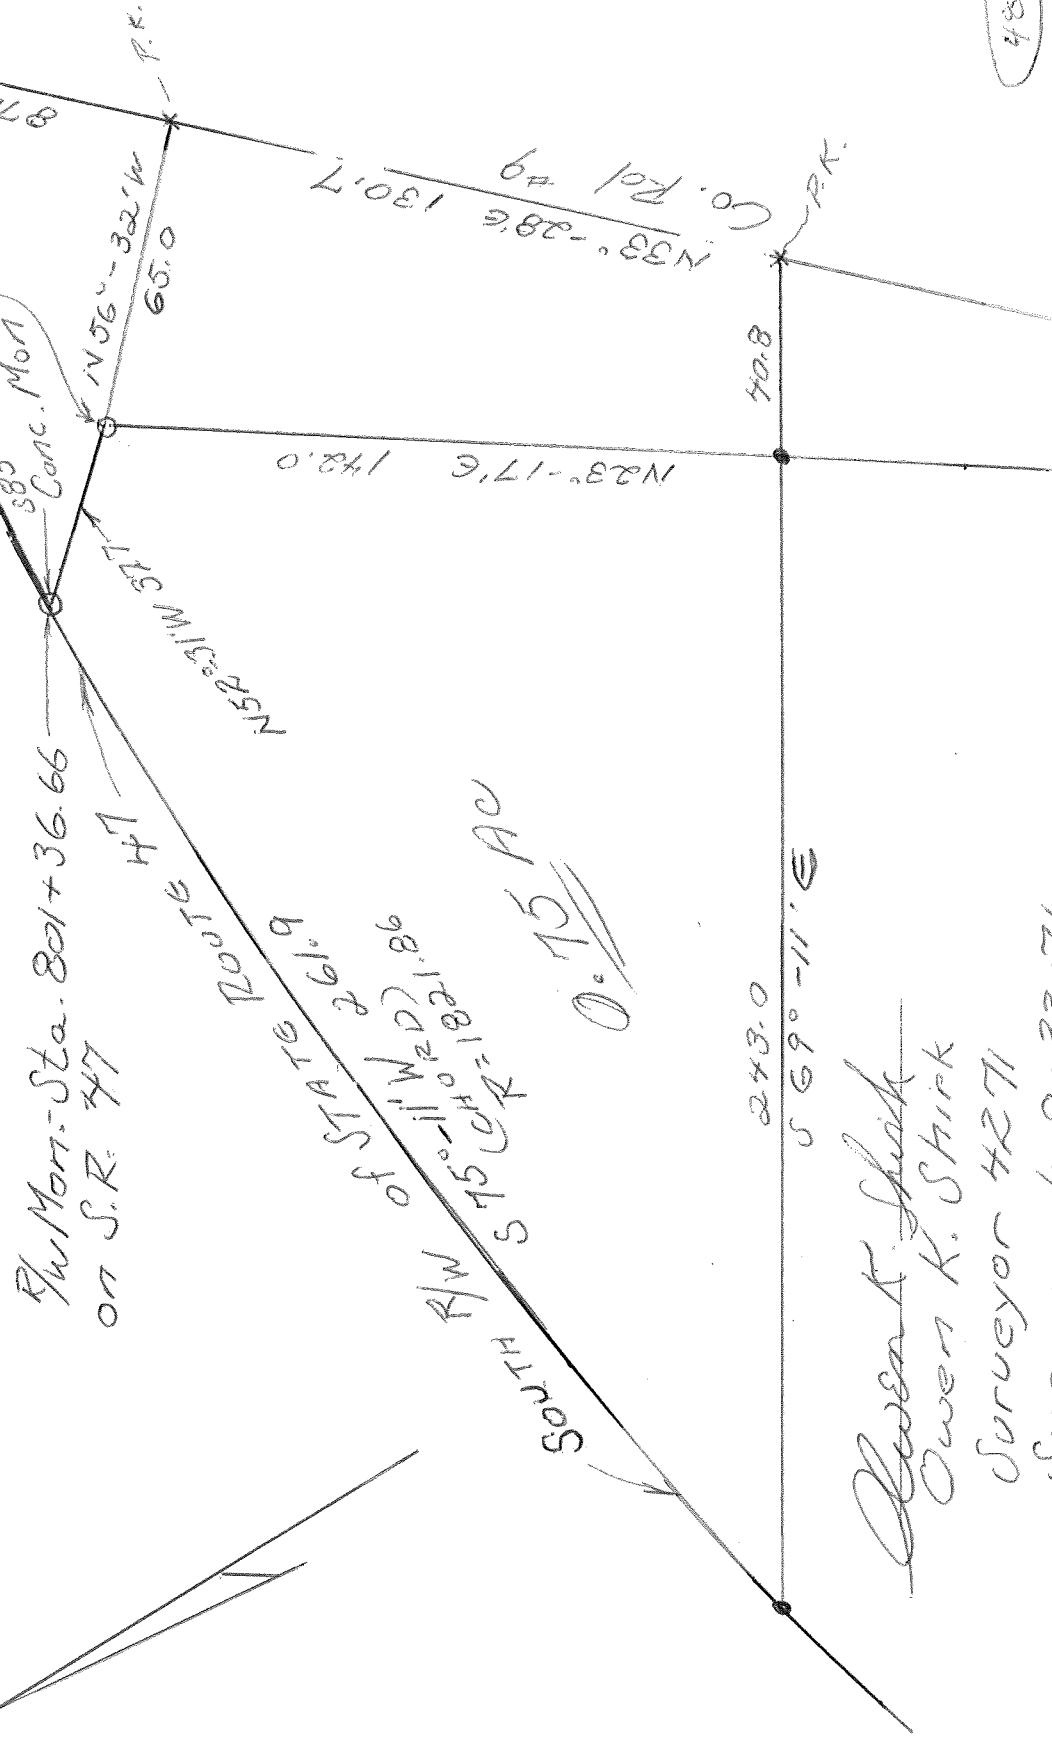

4882) 1P

*Glenart Shirk
Owner K. Shirk
Surveyor #271
Surveyed: 8-23-71*