

Water Line Lakeview Ohio


Hubs Placed 3' on Right
of Water Line.

See Page 49 for Witness
To Iron Pins.

1.C.H. Concrete Road
To Lima


144

INDEXED ON MAP

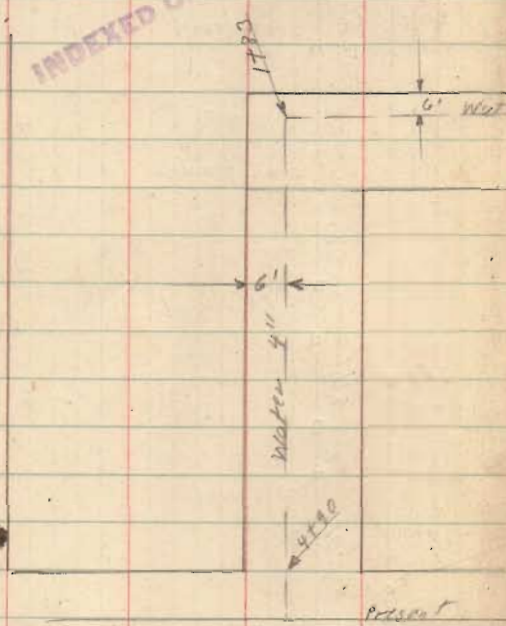

1709-15-1923
Warm.
Wright/
Dickinson
Kilgore.

48

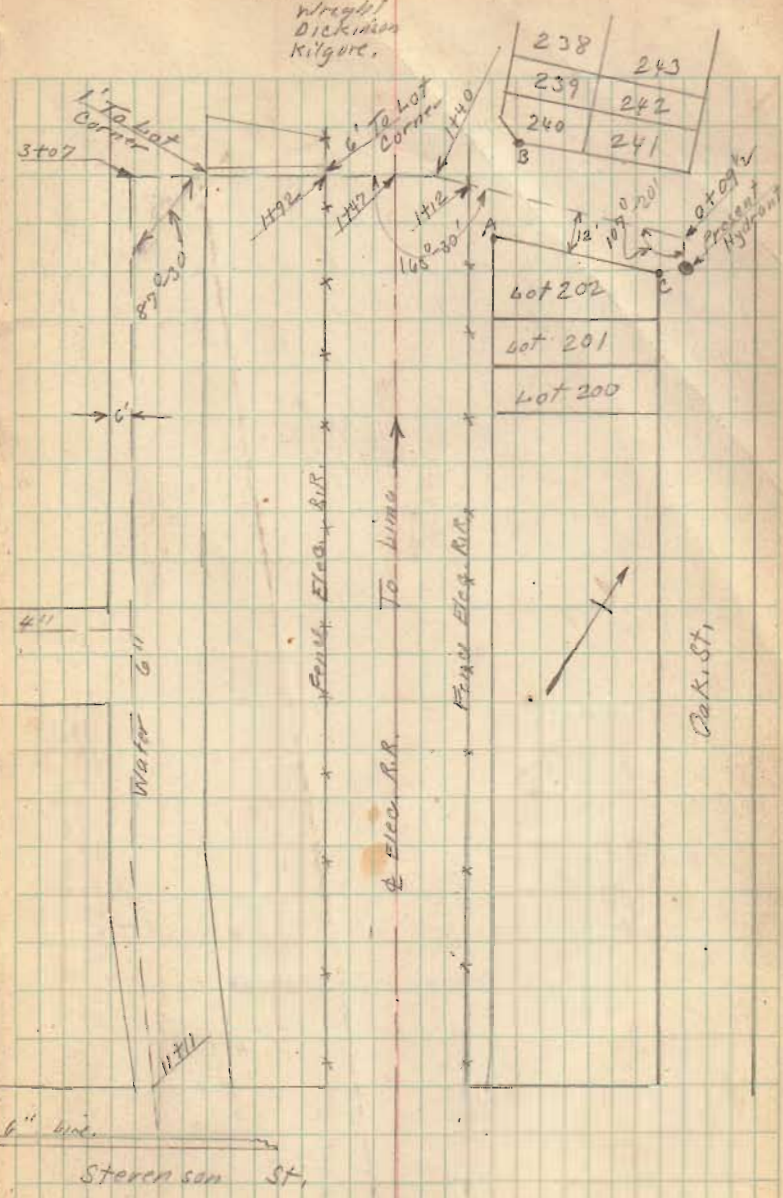

Sternson St.

Water Line Lake View

| | +S. | H.I. | -S. | Elev. |
|-------------|------|------|------|-------|
| B.M. | 1.92 | | | |
| 0+00 | | | 4.04 | |
| 0+09 | | | 4.60 | |
| 1+00 | | | 4.81 | |
| 1+41 | | | 3.73 | |
| Top of Rail | | | 2.52 | |
| 2+00 | | | 4.78 | |
| 3+07 | | | | |

INDEXED ON MAP

Aug 15-1923

Clear

Wright
Dickinson
Kilgore

49

