


Surveyed for Claude Brubaker
and Farmers Bank Co
sept 7 1925

WAM
Wm Downing

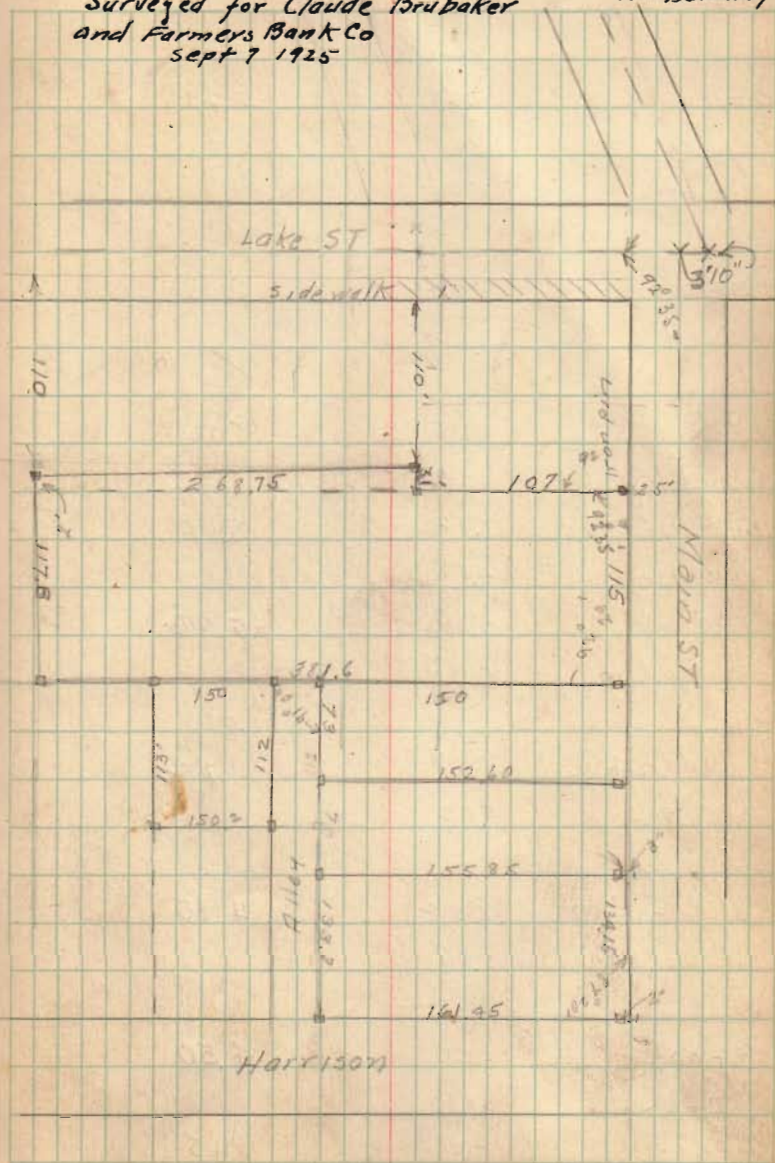

46

INDEXED ON MAP