


Shaffner Survey Lakeview Lots 79, 80, 81

245

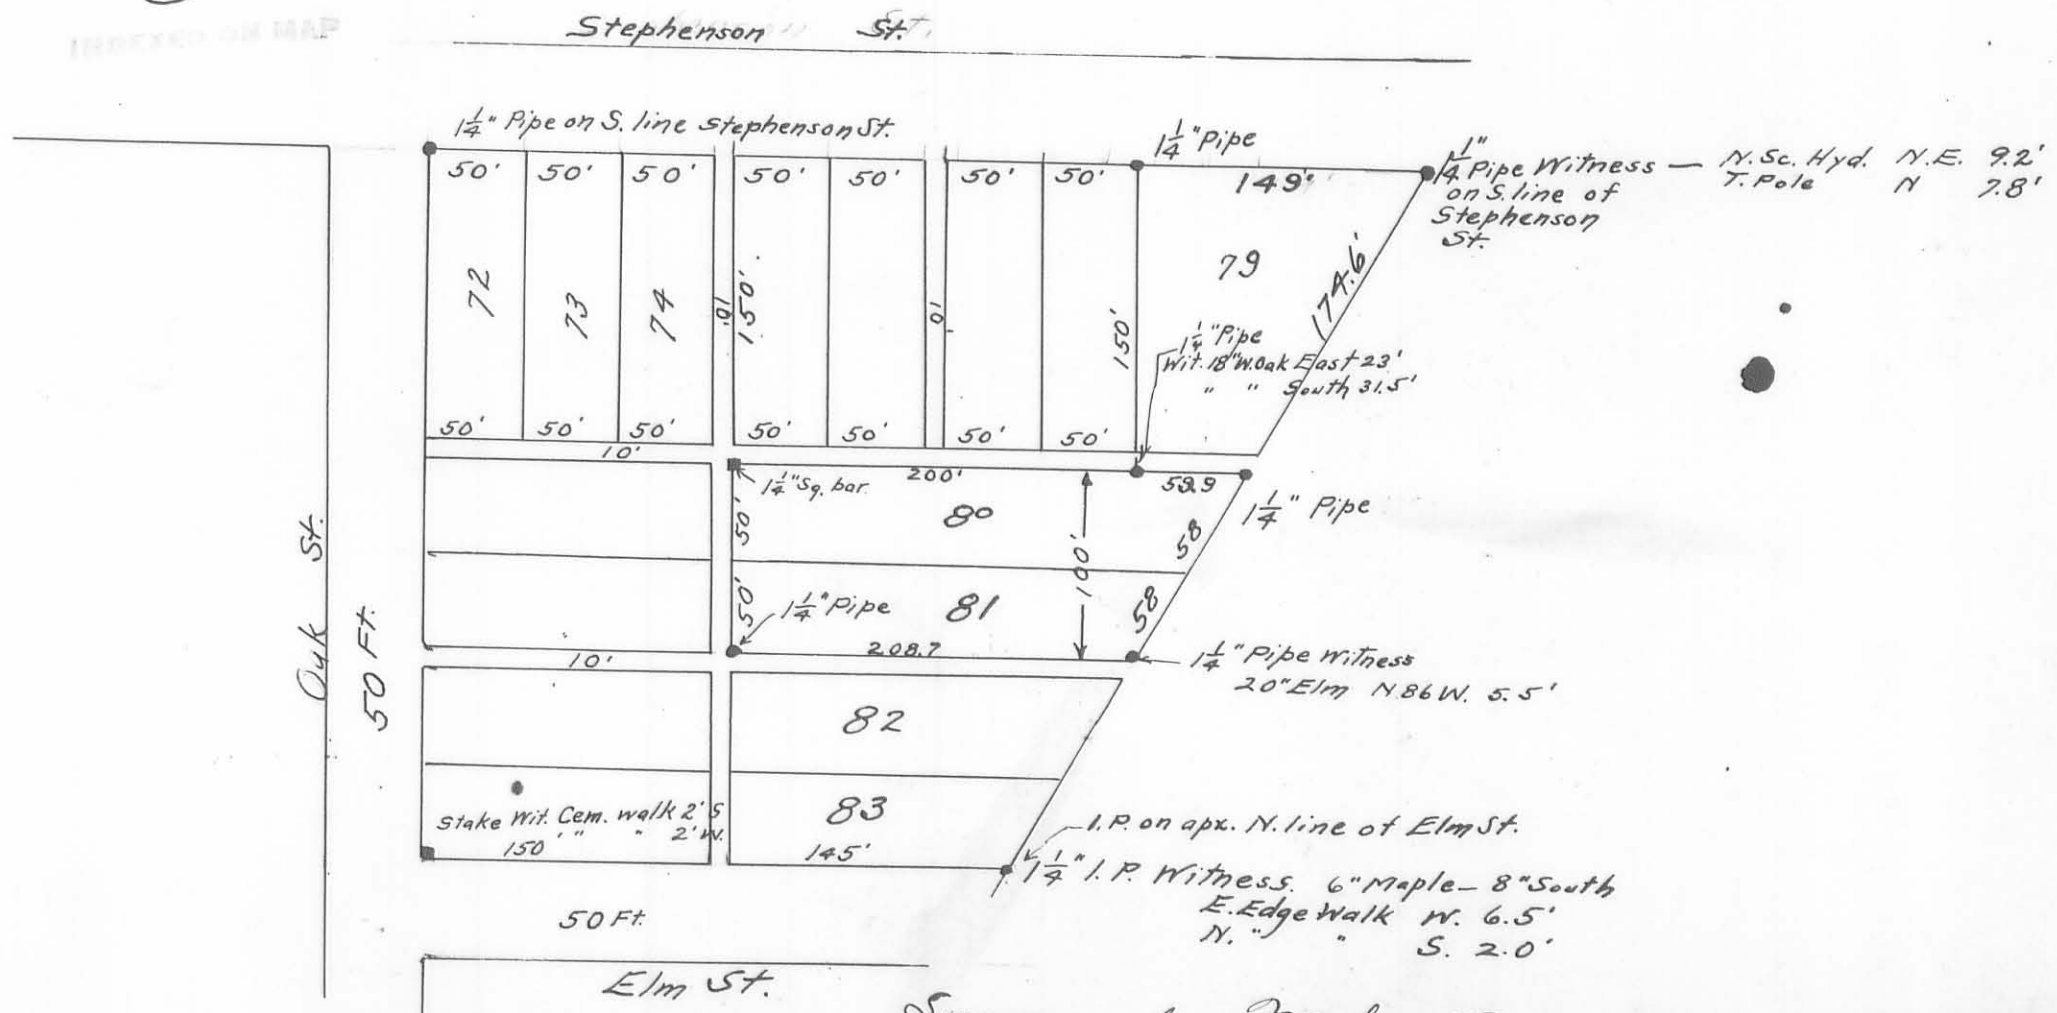

Surveyed Mch 18, 22
by Carl H. Newell
Deputy Co. Surveyor