

Mollenhour Survey Lakeview
 Lot # 35

Started at $\frac{1}{2}$ Harrison St. center between
 walks (N. walk 1'-0" from Property line)

Measured 66' from A. Fence between 29th & 30th St.

Then measured south as shown to $\frac{1}{2}$ of
 T. & P. C. Checked O.K. with Plat Book.
 Used Points on Main St. as shown.

Distance between Elm St. $\frac{1}{2}$ Main O.K. at south
 side of lots 35th & 37th

Measured at Rear of lots as shown
 beginning again at $\frac{1}{2}$ of Harrison St.

Noted small worm on rear of lot 30
 apparently O.K.

B. Oak Stake and Mark on walk placed by W.

C. R.R. Spike at edge of walk placed by Wright

D. Corner of lot. No stake set, as small
 building in the way. Set Oak stakes E & W
 as shown, 1'-0" out to hold corner.

G. Oak Stake placed by Wright


Used $\frac{1}{2}$ of Main St. $\frac{1}{2}$ of Pavement
 " $\frac{1}{2}$ " Elm St. $\frac{1}{2}$ Between Walks.

(687)

INDEXED ON MAP

Nov. -27-1920

Cold.
 Wright
 Kilgore

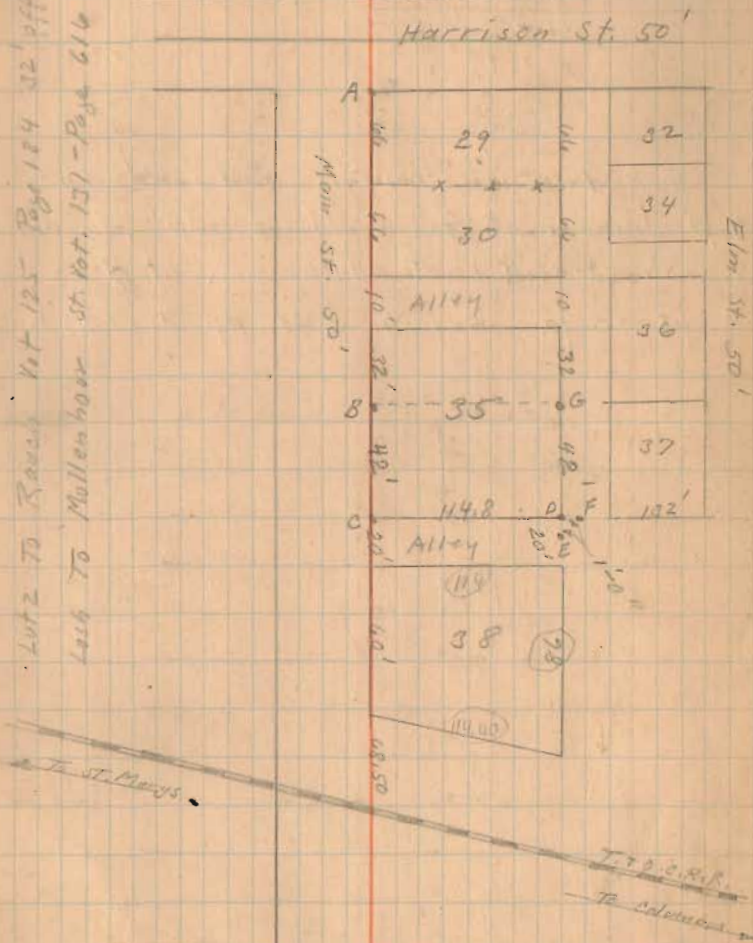

See Book 608 Pages 20-21-22