


1159

PROPERTY OF
STANDARD OIL CO


AT
LAKE VIEW, OHIO.

May 1911.

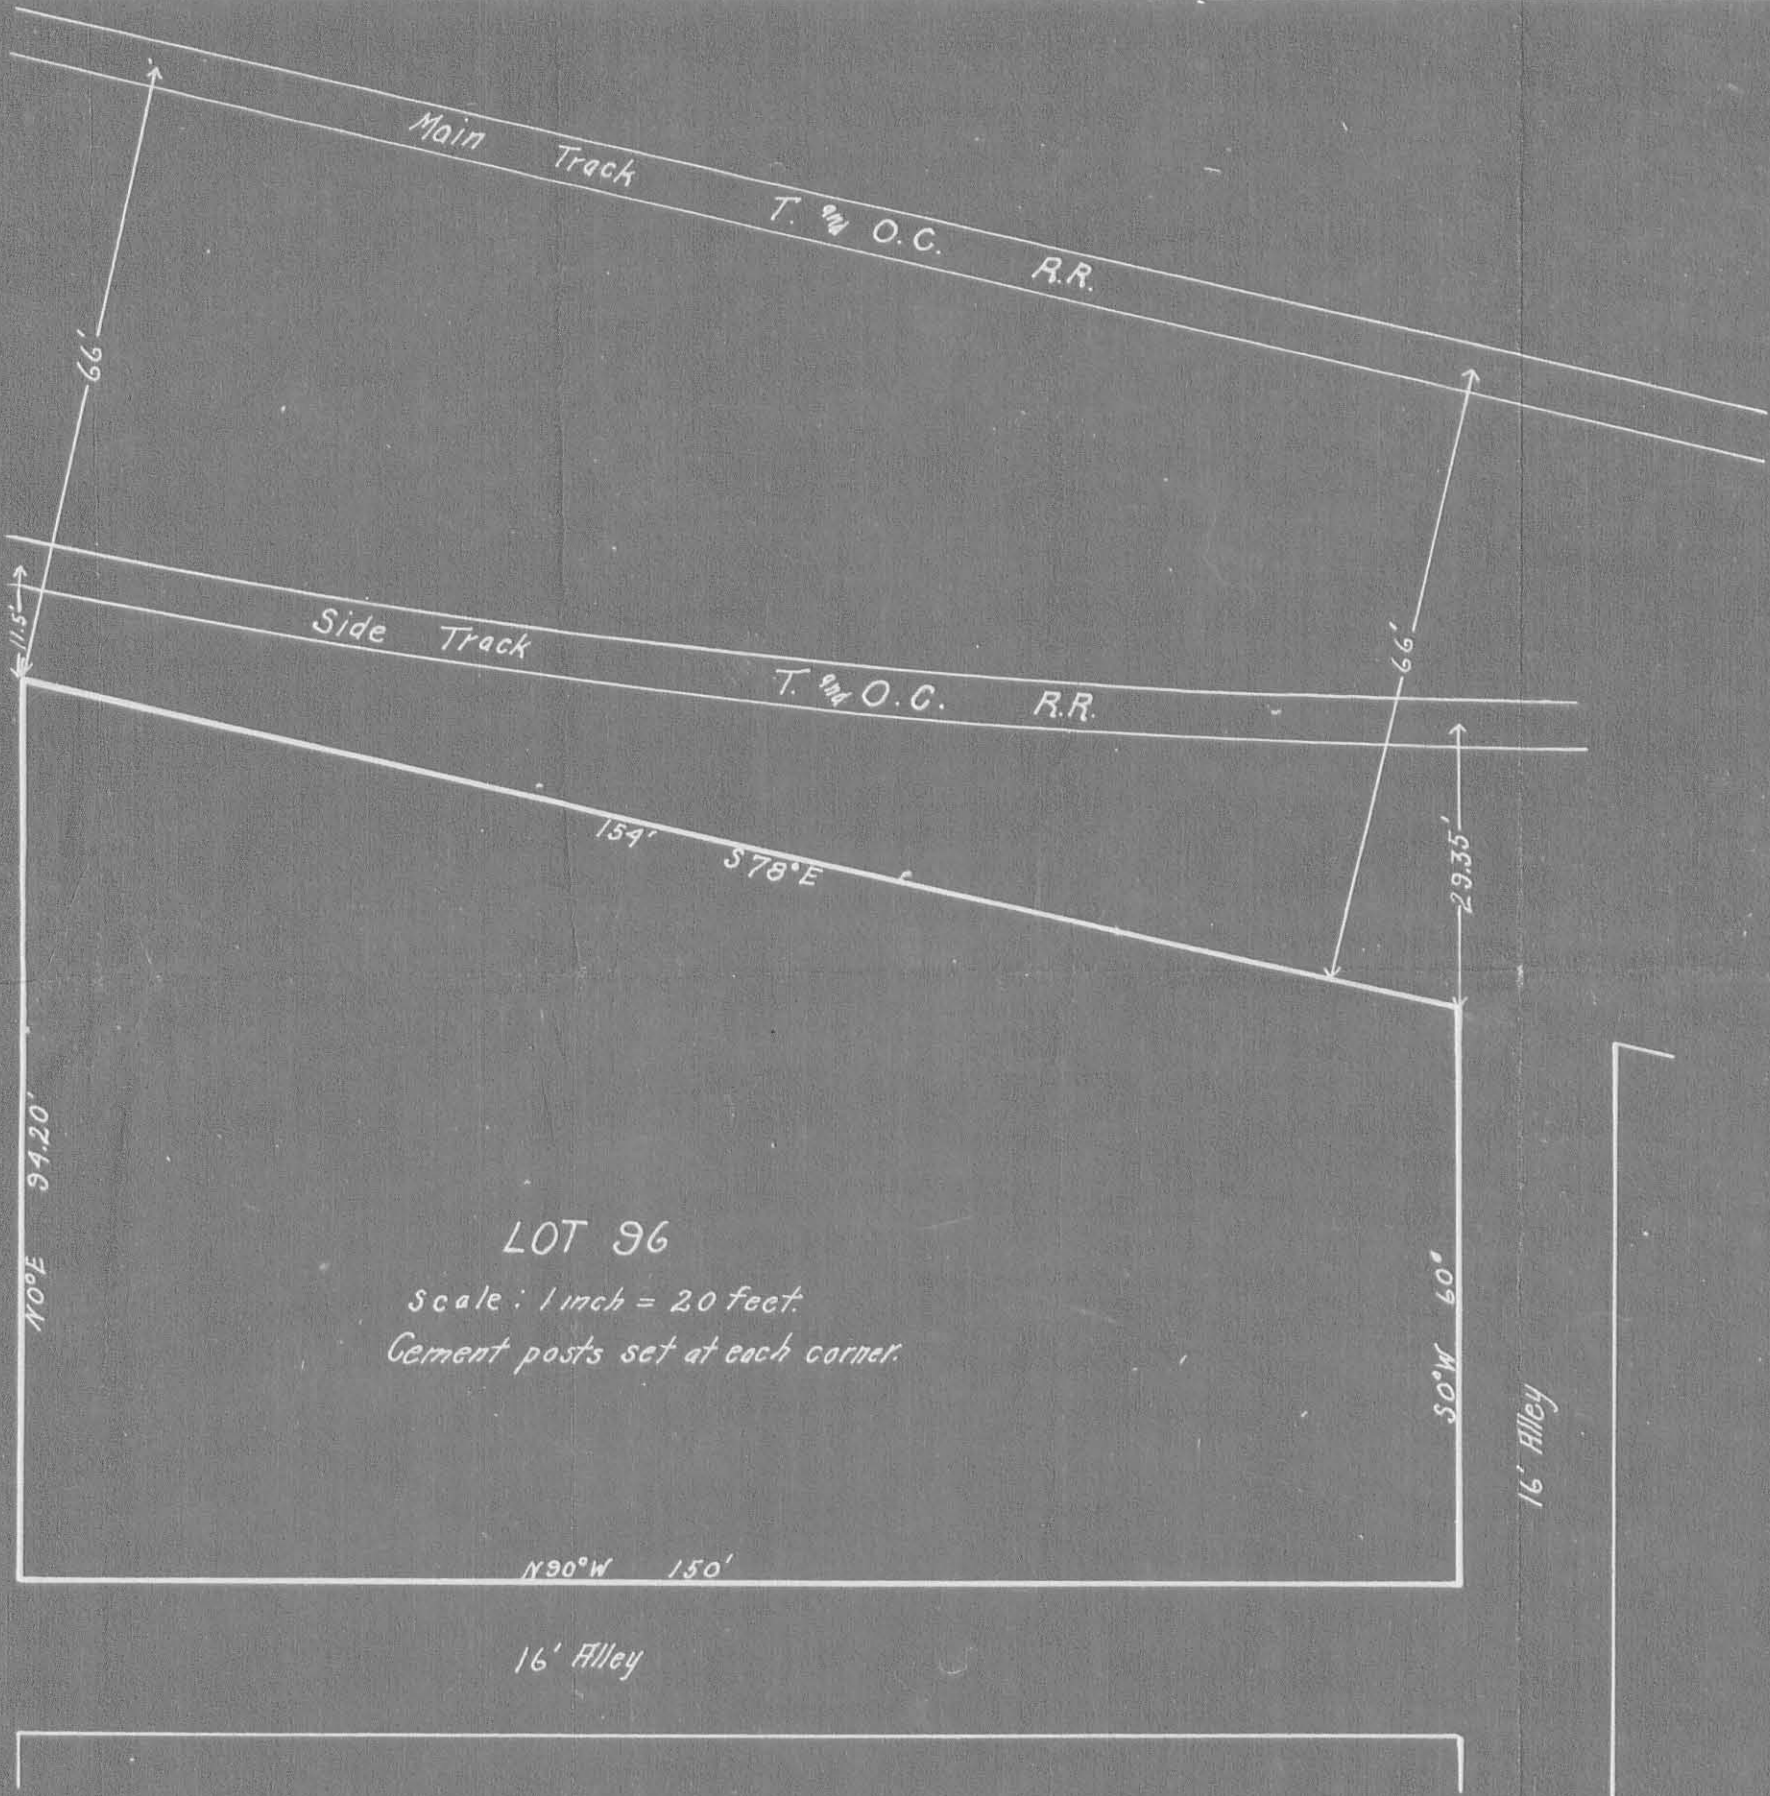

LOT 96

Scale: 1 inch = 20 feet.
Cement posts set at each corner.

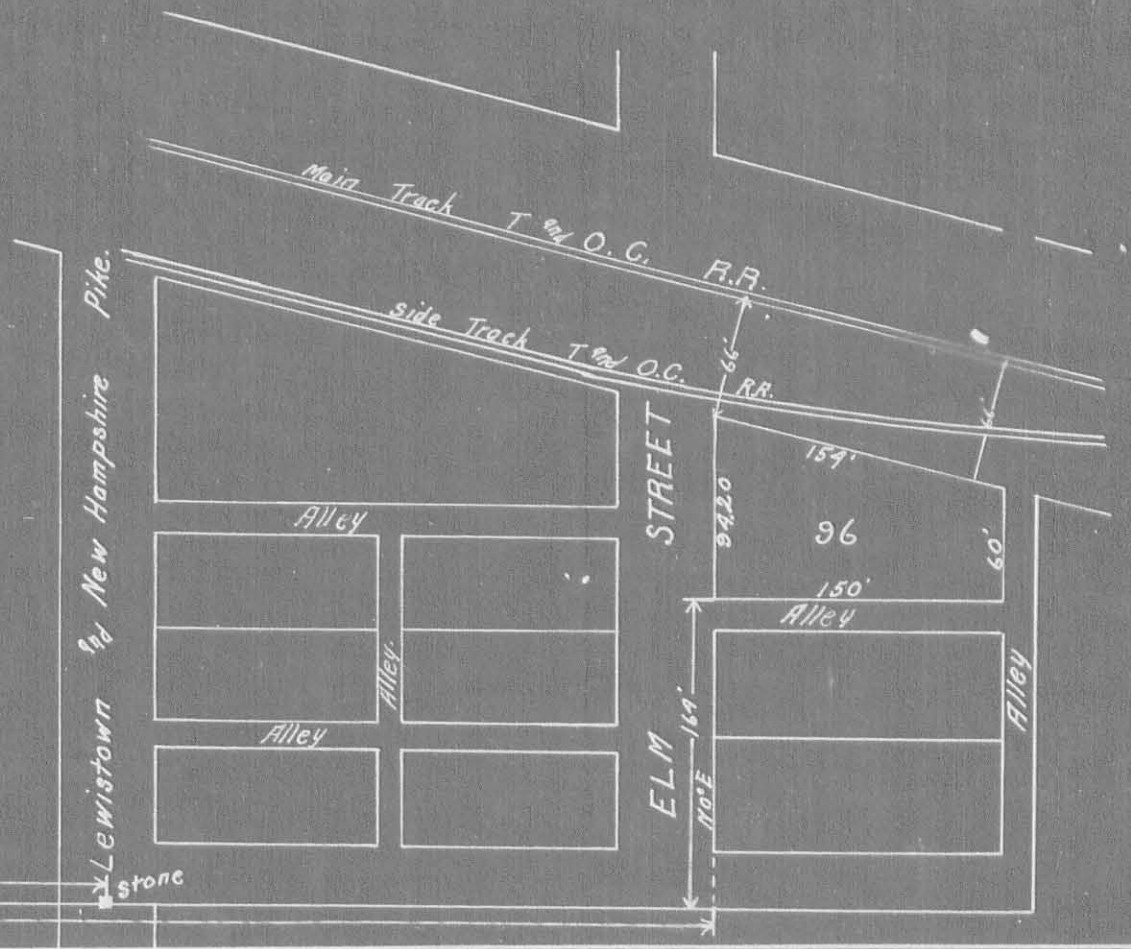

stone of Calvin Archers N.W. Corner.

875'

S 89° 45' E
1192'

stone

