

A. Shockey Lot Review.
Stenson's Addition.


See Page 56⁹ & 57 for location
of lot.
Measurements as shown.

- A - 1" Iron placed 42" long. Against walk
- B - 1" " " " " " "
- C - Hub Placed.
- D - Hub Placed.

Cut Notch in walk by Irons.

July 2-1925

58

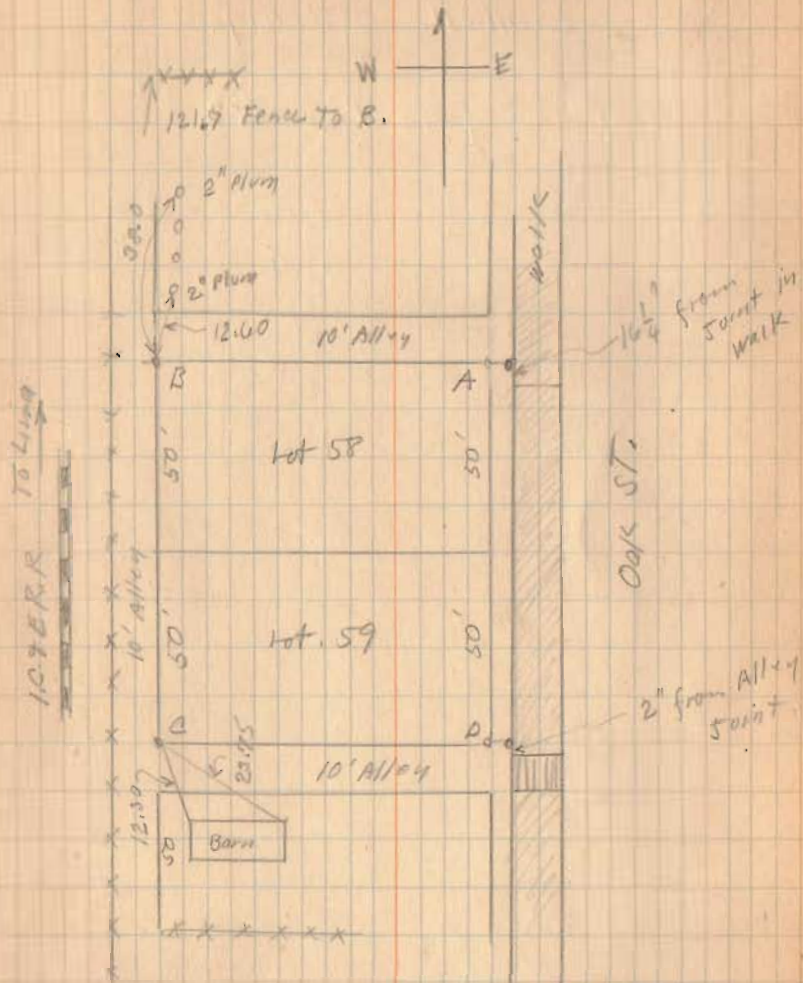

INDEXED ON MAP

1164