

(1166)

INDEXED ON MAP.

School lot. Lakeriver.
Old School

this Plot shows original lots.


Ada Duff Vol. 104 Page 180

This deed calls for all land from
 $\frac{1}{2}$ Sec. Line To Numbered Lots and
N. To Out lot. 1 Also 50' off
of W. side of lot. 26

Cagill To Blackney Vol. 129 Pg. 460
35' off of West side of 24

Roach To Serviss Vol. 129 Pg. 438
50' off of East side of 24

Note this calls for 85' out of
82' lot. Fences indicate it had
been squared and is stated in
85 miles from lot 23.

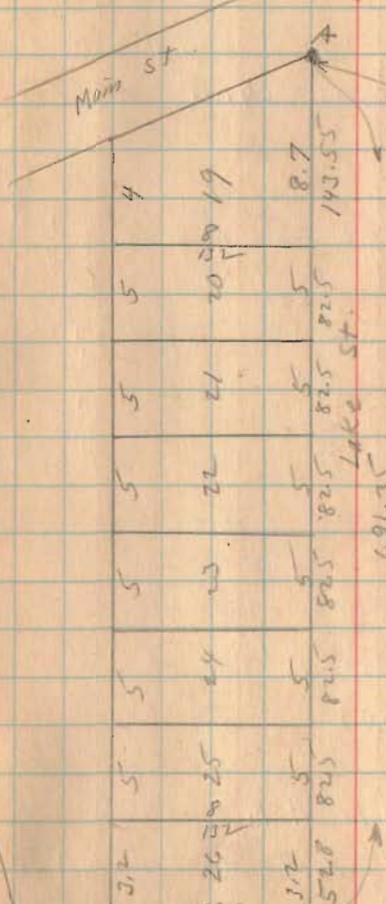

Sept. 21, 1929
Clear
Wright
Billy.

20

I. Pin See Book 419
Page 13

B I. Pin See Book 419
Page 17

2 ~ 17 205²
M.N.)

(727 pages)

School Lot taken over
old school

Placed Iron at E 641.35
from A (691.35 - 50) = 641.35

Morris Deed Vol. 88 Page 606

Pt of 25

Begins 50' E. of S.W. cor. of 26'
E. 50'

N. to End of lots
W. 50'

S. to Beginning

Placed Stake at D

Placed Iron at C, (85' from fence
See Note page 20)

Turned 90° set stake at K.

Placed L at old Post on Line M.J.

Placed $\frac{1}{2}$ " Iron at F

Placed Stake at G

Placed 2" Pipe at H.


Turned 90 and placed stake at I

This is at intersection of Line M.J.
+ ILM all on line.

Note 2' of Thru
would be 10'
40' + 26' = 66'
26' Deed does not
mention top. 26'

9-21-25

21

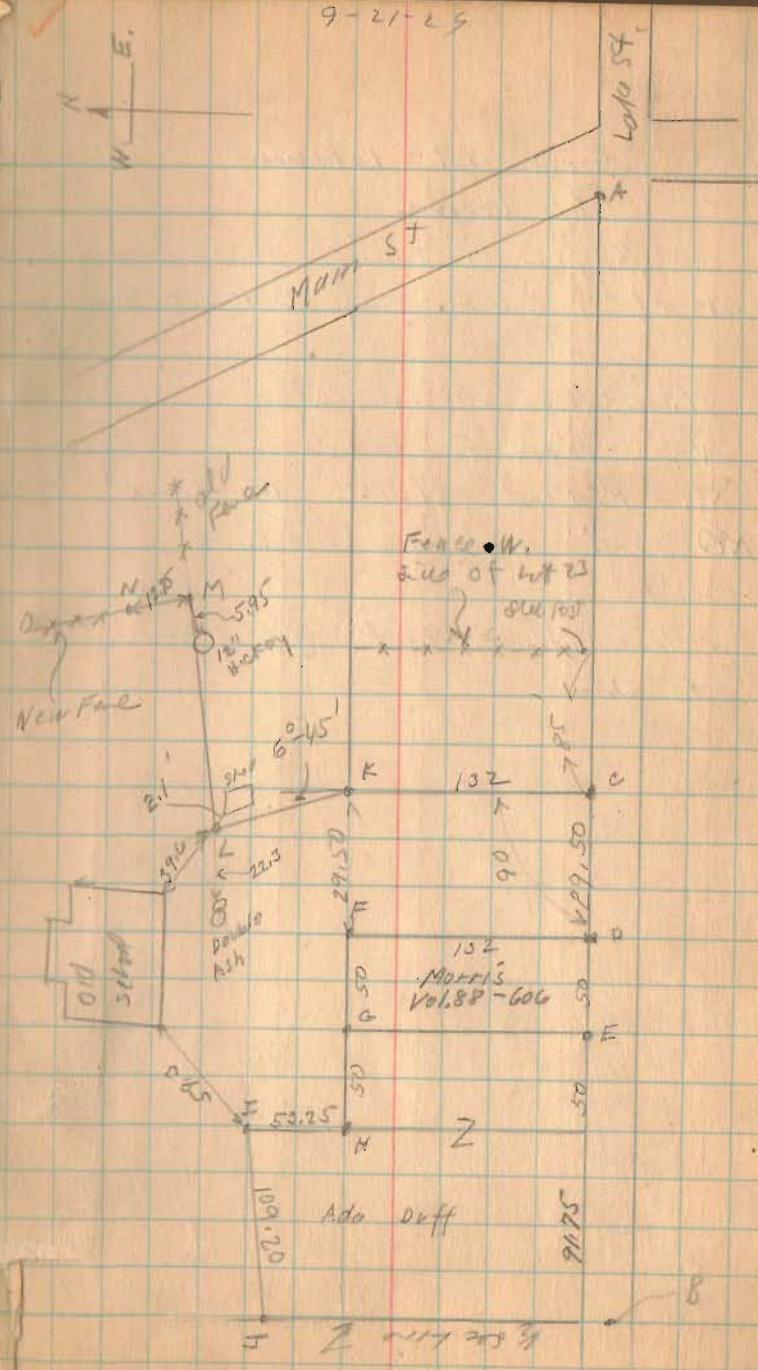

9-21-29

22

School lot Lakewood

Old school

J Angle Post in concrete
at old corner of lot lot #1

N. Post in concrete

NO New Fence

M. Placed staves in line
NO and Old Fence line.

On line M noted old fence
posts O.K.

