

Lot. 35 Wakeriew
Frank Mullerhour.
Sec. 34 T. 6 S R. 8 E.

See surry (687) Book 417 Page 11


See surry (658) Book 480 Page 21 & 22

Flat


See Page 21

1754

INDEXED ON MAP

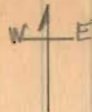

Oct. 23-1936
Cloudy
F. Wright
S. Posky . 20

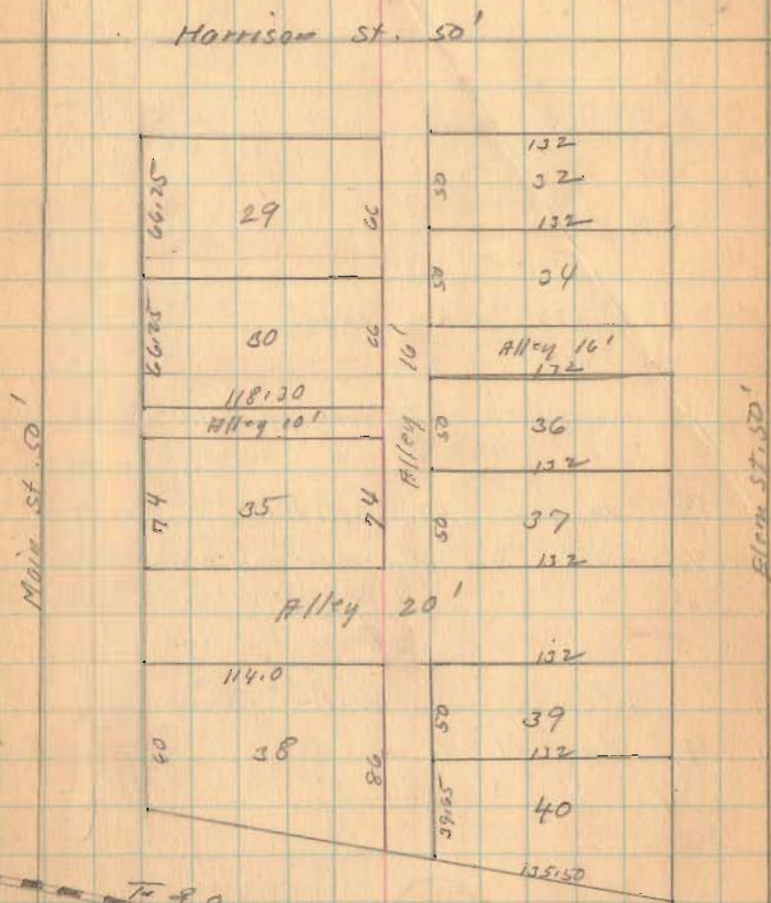

(over)

Lot 35 Lakewood.

- H 7/4" Pipe Found.
- B " " "
- C " " "
- D " " "
- E 2" X 2" X 24" Hub Placed.
- F " " " "
- G 3/4" Reinf Iron 9th Mark on Wall Placed
- H " " " " " " "
- I 1 1/2" Pipe found 42.0' N. of G.
- J 3/4" Reinf Iron and mark on wall Placed.
- K " " " " " " "
- L " " " " " " "
- M Small Cross on Wall found O.K.
- N 3/4" Pipe Placed.
- O 3/4" " "

1754

INDEXED ON MAP

10-23-36

21

