


FB 699

Harrison St.  
Lakeview, Ohio  
50' wide

D. E. Dodson  
V. D. Detrick  
T. L. Richardson

May 17, 1952  
75° 11

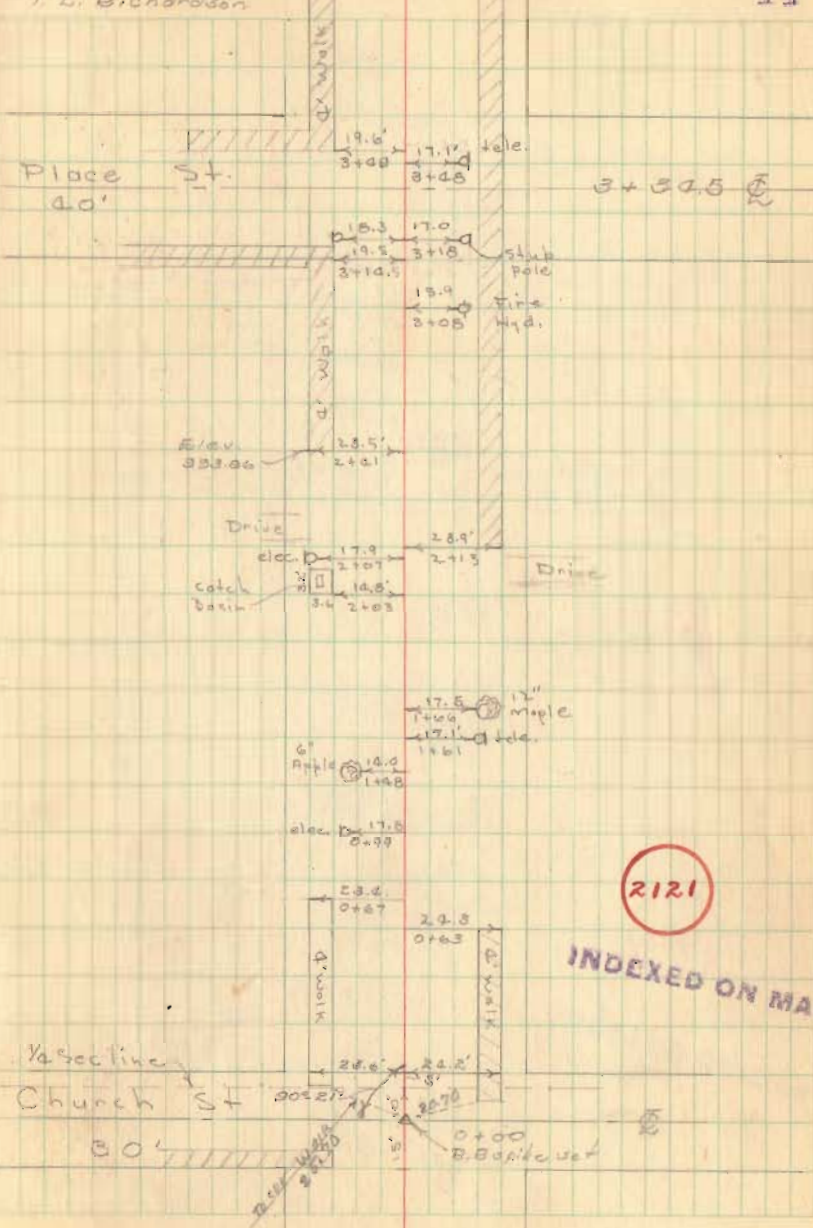


2121

INDEXED ON MAP



LITTLETON CO. 03/11/1952

3/4" pipe  
S. E. Cor.  
School lot

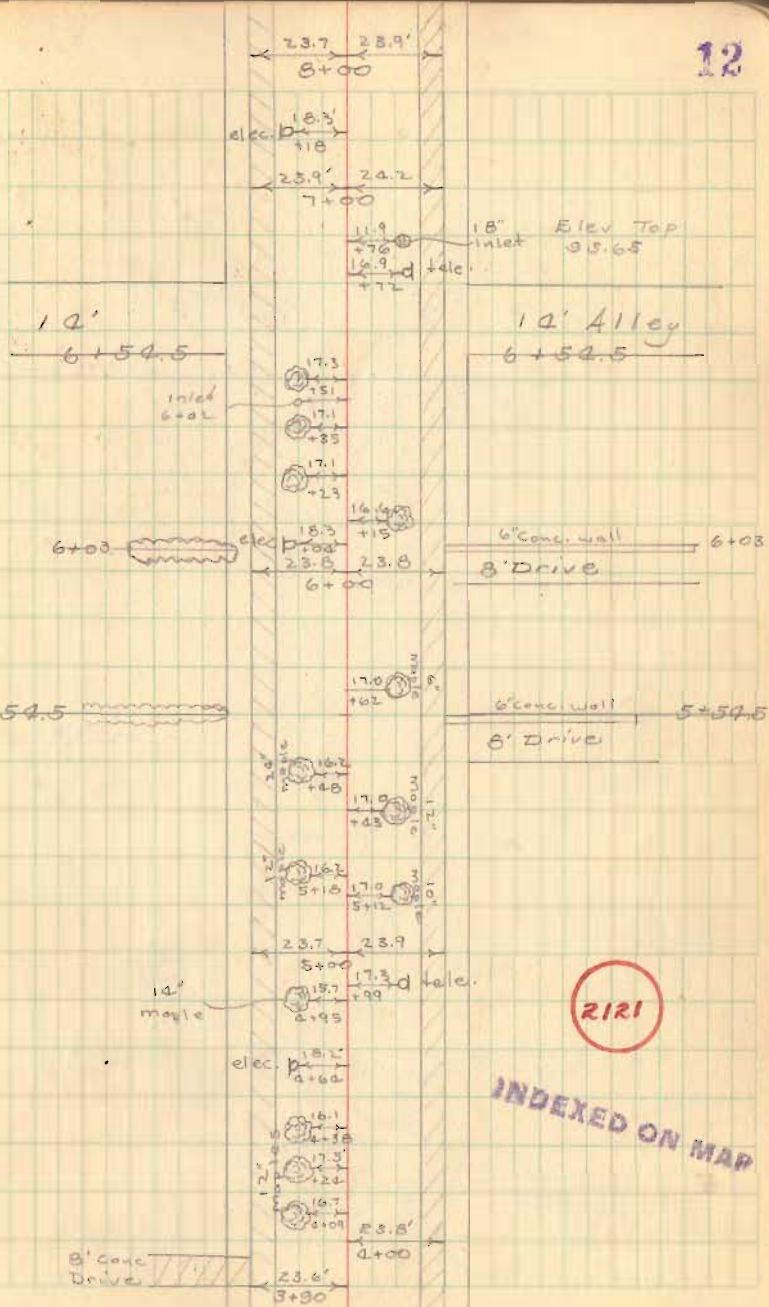


FB 699


Harrison St.

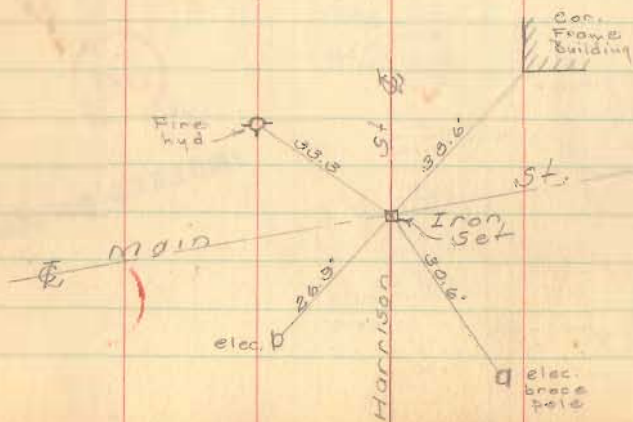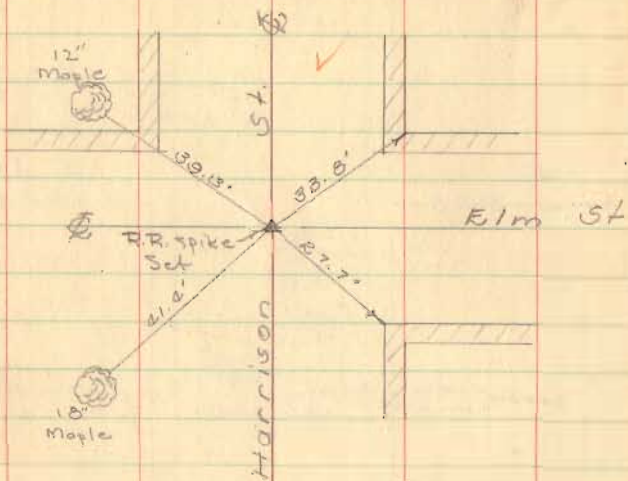

13

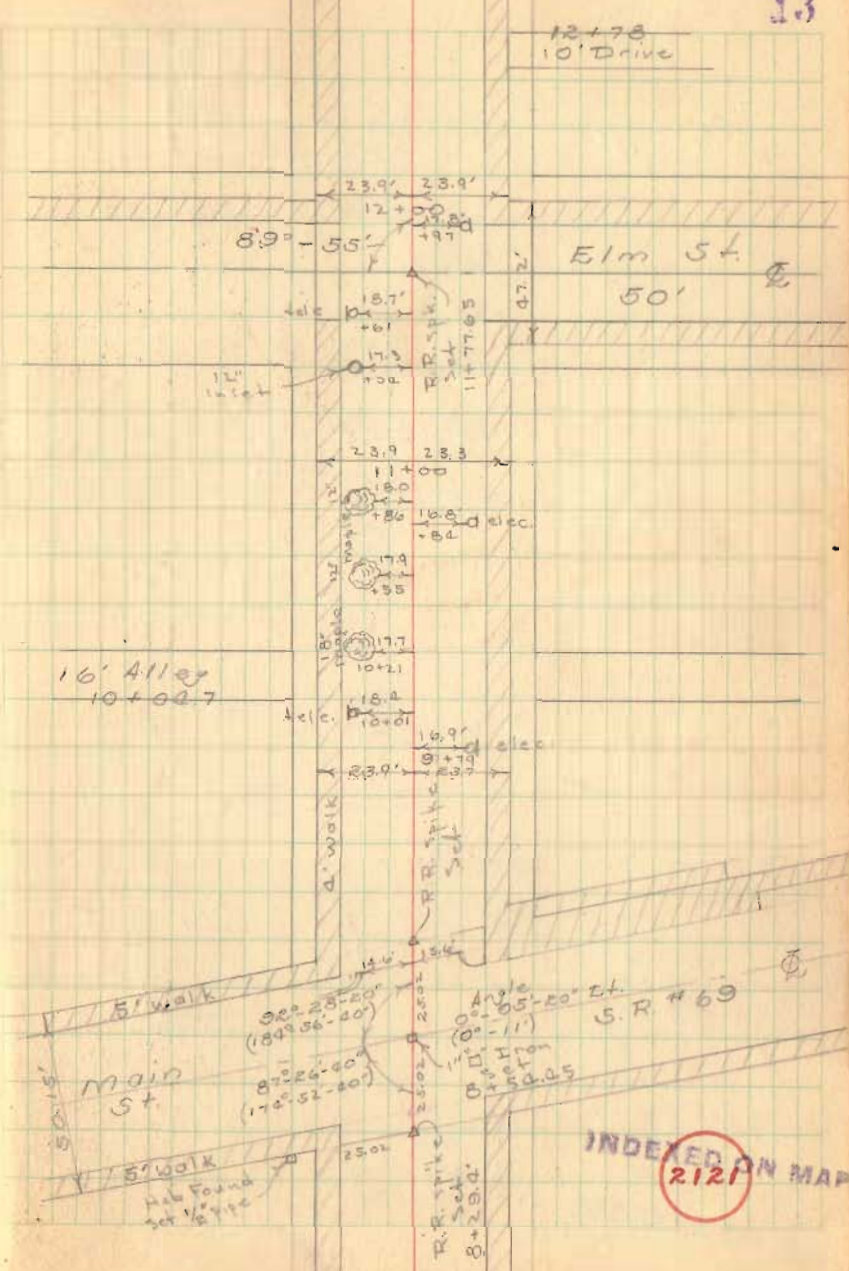

INDEXED ON MAP  
2121

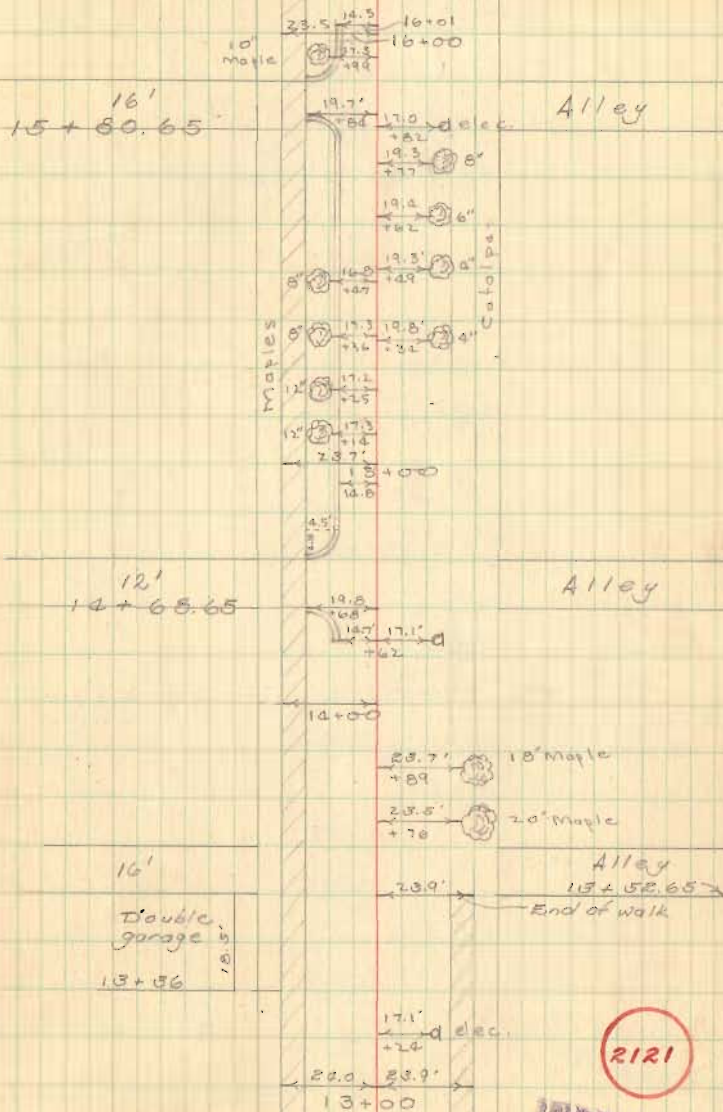



2121

INDEXED ON MAP


FB 699

Harrison St.

15

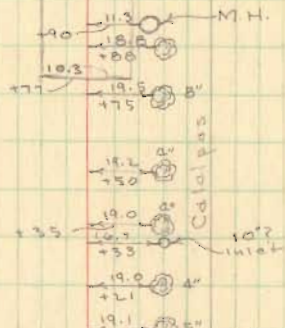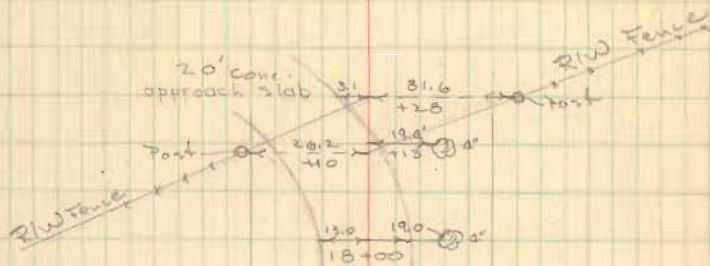

12'  
 16+96.65  
 End of Walk

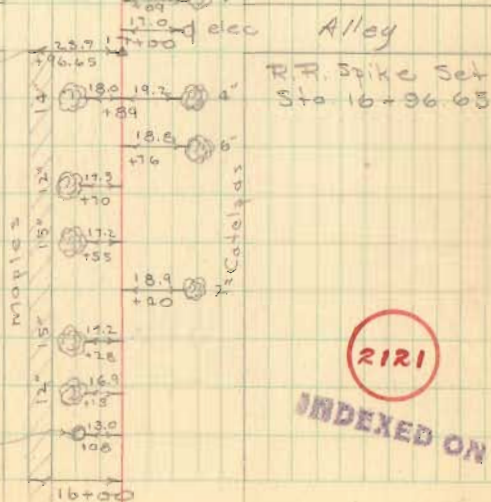

2121

INDEXED ON MAP

FB 699

## Harrison St - Levels

Sta	+S	HI.	-S	Elev.
Bm <sub>1</sub>	6.025	995.992		989.967
Bm <sub>2</sub>	5.224	996.616	4.600	991.992
	7.801	1001.570	2.827	993.763
Bm <sub>3</sub>			3.565	993.005
	5.006	1001.154	5.512	996.056
Bm <sub>4</sub>	3.705	993.123	5.736	995.418
Bm <sub>5</sub>			3.493	995.630

## Check Levels

Bm <sub>5</sub>	3.272	993.102		995.630
Bm <sub>4</sub>	6.241	1001.651	3.622	995.410
Bm <sub>3</sub>	3.151	1001.122	3.680	997.971
	3.853	996.545	3.400	992.692
Bm <sub>2</sub>	4.400	995.750	5.203	991.342
			5.836	990.912

D. L. Dodson  
 V. D. Detrick  
 T. E. Richardson

17

Bm<sub>1</sub> Chiseled 4" center top step N.E. wing of  
 Br. on S.R. # 33 over Houshins Slough Dt.

Bm<sub>2</sub> Chiseled 4" center of conc. culvert headwall  
 at intersection Harrison St. & S.R. # 33

Bm<sub>3</sub> top 4" hose connection Fire hyd N.E. cor. Harrison-Main

Bm<sub>4</sub> top 2" hose connection Fire hyd. S.W. cor. Harrison-Place

Bm<sub>5</sub> top 4" connection - Fire hyd. S.W. cor. Harrison & Church

2121

INDEXED ON MAP