

Survey for Homer Stabler
Lake View.


S. 34, T. 6 S., R. 8 E.

See notes of F.E. Wright.

Book 419 Page 9

- B - Iron bar (found)
- C - Small iron bar (found - Wright)
- D - Nail in walk (Wright)
- E - Iron bar (found) (Wright)
- F - Iron pipe (found) (Wright)
- H - Stake (found) (Wright) / new stake
- N - Pipe placed 1'-3" of 5' walk
- M - 4'- $\frac{3}{4}$ " pipe set
- O - Pipe placed 1' 5" of 5' walk
- P - 4'- $\frac{3}{4}$ " pipe set
- Q - Pipe placed 1' 5" of 5' walk
- R - pipe set
- S - Iron post (found.)
- T - Iron bar (found)

C. A. Inskip. 3-20-87 18
J. H. Inskip
G. C. Inskip
North

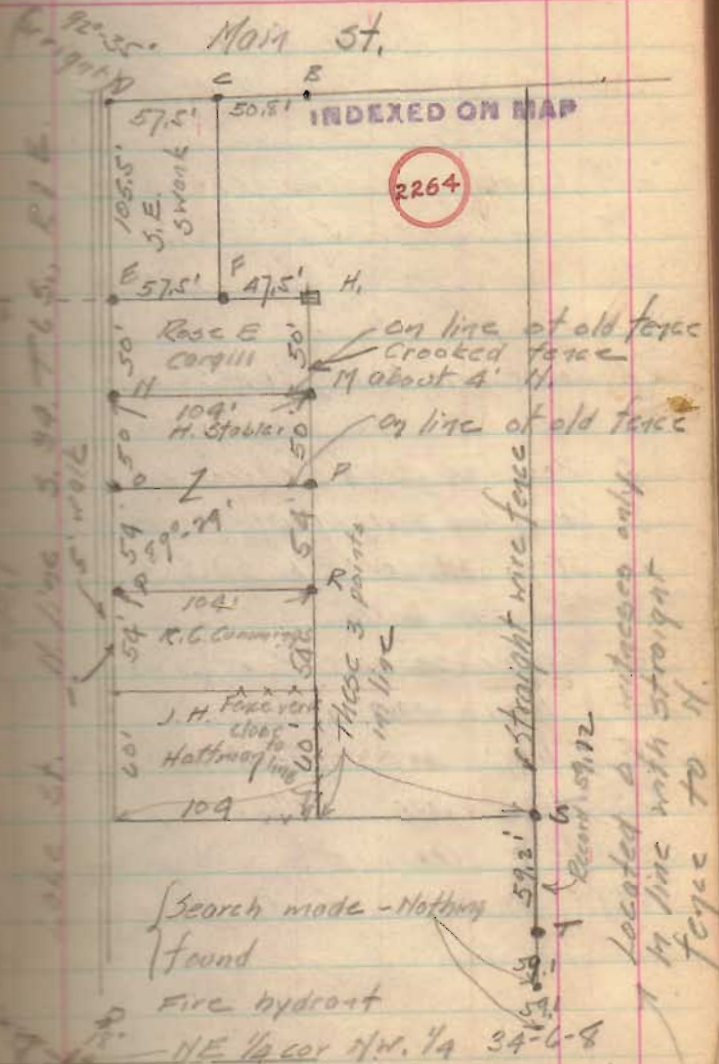

see book 419 Page 9. $\frac{1}{4}$ cor not found