


Survey of parts of
Lots 136 and 137 in Lake View
for
Harry Pugh Job No 130.

637-87
2A. 1/2 sec 136
1/2 sec 137
1/2 sec 138

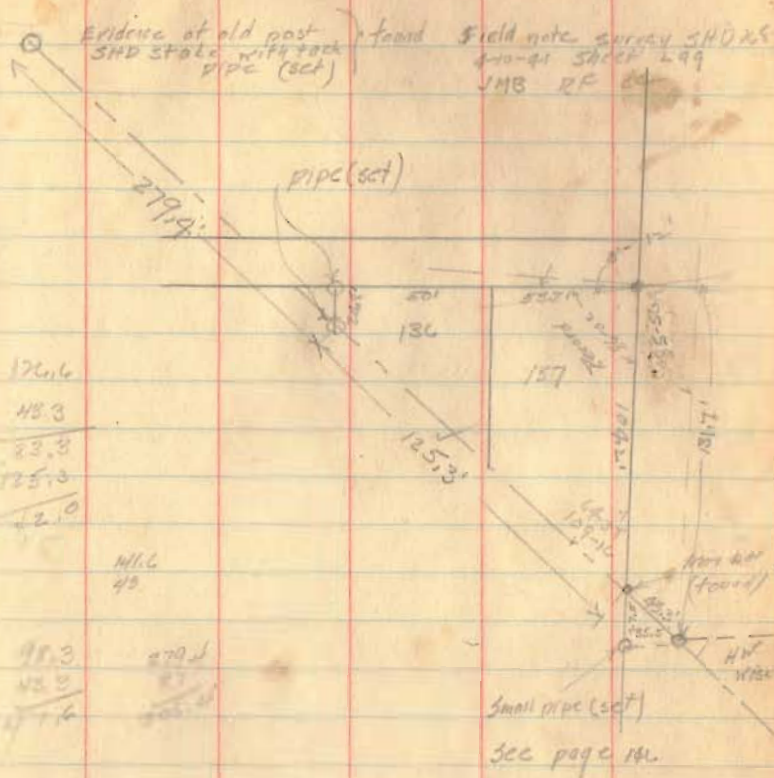

INDEXED ON MAP

2352