



SYMBOLS:

- - P. K. Nails Set.
- ⊗ - 5/8" x 30" Rebars Set.

HENDERSON SURVEY
 Lots No. 527-528
 Village of Lakeview
 Stokes Township
 Logan County, Ohio
 October 26, 1992

Daniel E. Gilbert

DANIEL E. GILBERT, P.S.
 REG. SUR. NO. 5402
 400 N. PARK ST.
 BELLEFONTAINE, OHIO 43311
 TELEPHONE: 1 (513) 593-1428



INDEXED ON MAP
 5787 1P



Scale: 1" = 20'


N

GROVE AVE. - 40'

IRON PIPE
FD. 30.0'

IRON BAR
FD.

STATE ST. - 40'

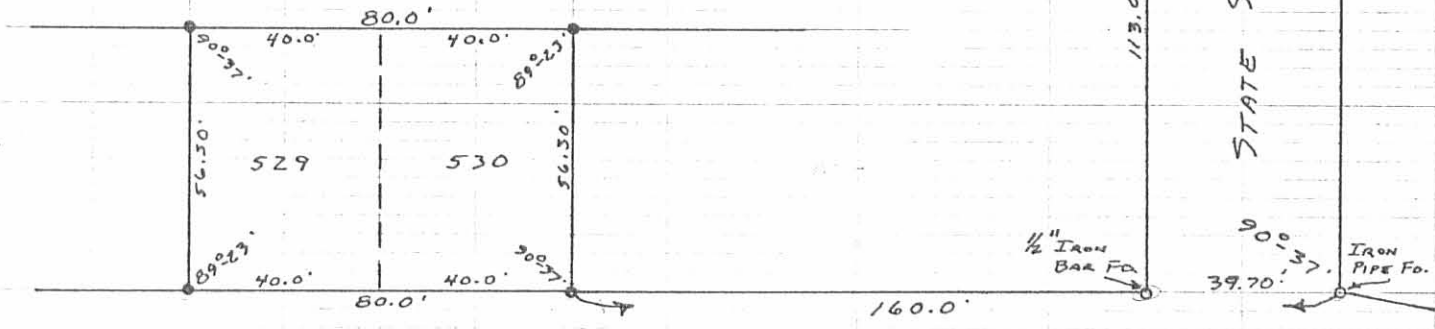

BENTZ AVE. - 30'

1/2" IRON
BAR FD. 39.70'

8 - 5/8" ϕ IRON BARS SET.

REFERENCE:

NICHOLSON'S 5th ADDITION
PLAT BOOK C VOL. 3 PAGE 7.

5787 28

INDEXED ON MAP

PEARSON SURVEY
LOTS 529, 530
VILLAGE OF LAKEVIEW
STOKES TOWNSHIP
LOGAN COUNTY, OHIO
MAY 17, 1975

SCALE: 1" = 40'

SURVEYED AND PLATED BY:

DANIEL E. GILBERT, P.S.
REG. SUR. No. 5402
1041 N. MAIN ST.
BELLEFONTAINE, OHIO 43311