

Siebert to Madden Survey

The following described real estate situated in the Village of Lakeview, Township of Stokes, County of Logan, State of Ohio and being a part of Section 27 T. 6 S. R. 8 E. and being more particularly described as follows:

Beginning at an iron bar at the southeast corner to Robert V. Madden's present 0.07 Acre tract and the northeast corner to Charles A. Siebert's present 0.07 Acre tract in the west line of Hull Street (so called);

Thence with the line between Madden and Siebert, S. 71° 00' W. 45.80 feet to a point;

Thence S. 36° 00' E. 8.56 feet to an iron bar;


Thence N. 64° 00' E. 45.10 feet to an iron bar in Siebert's east line and the west line of Hull Street;


Thence with Siebert's east line, N. 19° 00' W. 3.00 feet to the place of beginning, containing 261.79 square feet or 0.006 Acres, more or less.

I hereby certify that this is an accurate description of a survey made by me on February 14, 1976 and being out of the northeast corner to Charles A. and Ada M. Siebert's present 0.07 Acre tract as recorded in Deed Volume 280 Page 427.

*Daniel E. Gilbert*

Daniel E. Gilbert, P.S.  
Reg. Sur. No. 5402  
1041 N. Main St.  
Bellefontaine, Ohio 43311

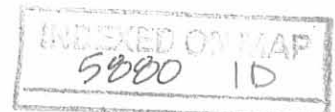

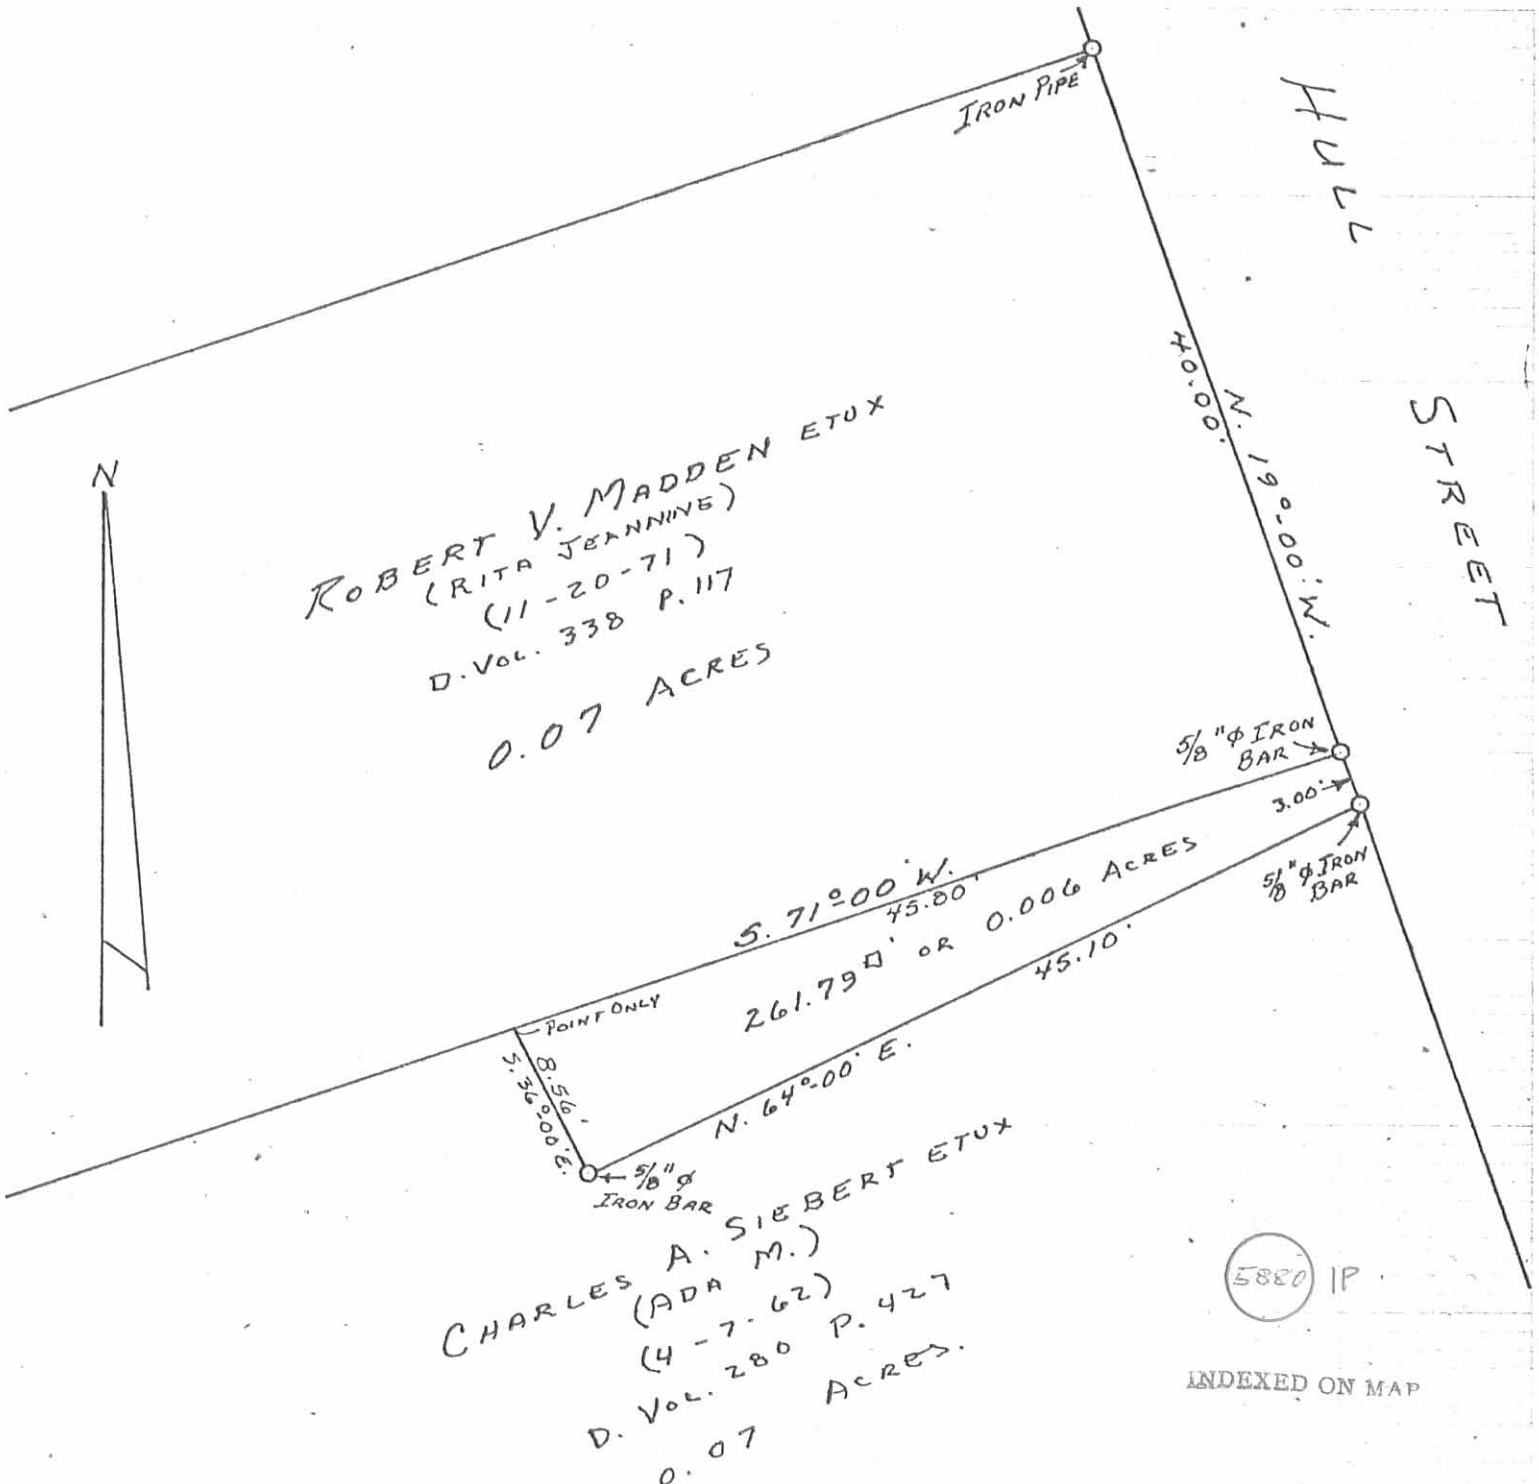

SURVEYED AND PLATTED BY:  
 DANIEL E. GILBERT, P.S.  
 REG. SUR. No. 5402  
 1041 N. MAIN ST.  
 BELLEFONTAINE, OHIO 43311

SIEBERT TO MADDEN SURVEY  
 SECTION 27 T.6S. R.8E.  
 VILLAGE OF LAKEVIEW  
 STOKES TOWNSHIP  
 LOGAN COUNTY, OHIO  
 FEBRUARY 14, 1976  
 SCALE: 1" = 100'