
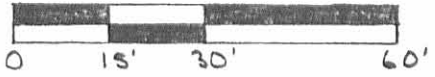


GROVE AVENUE (30')

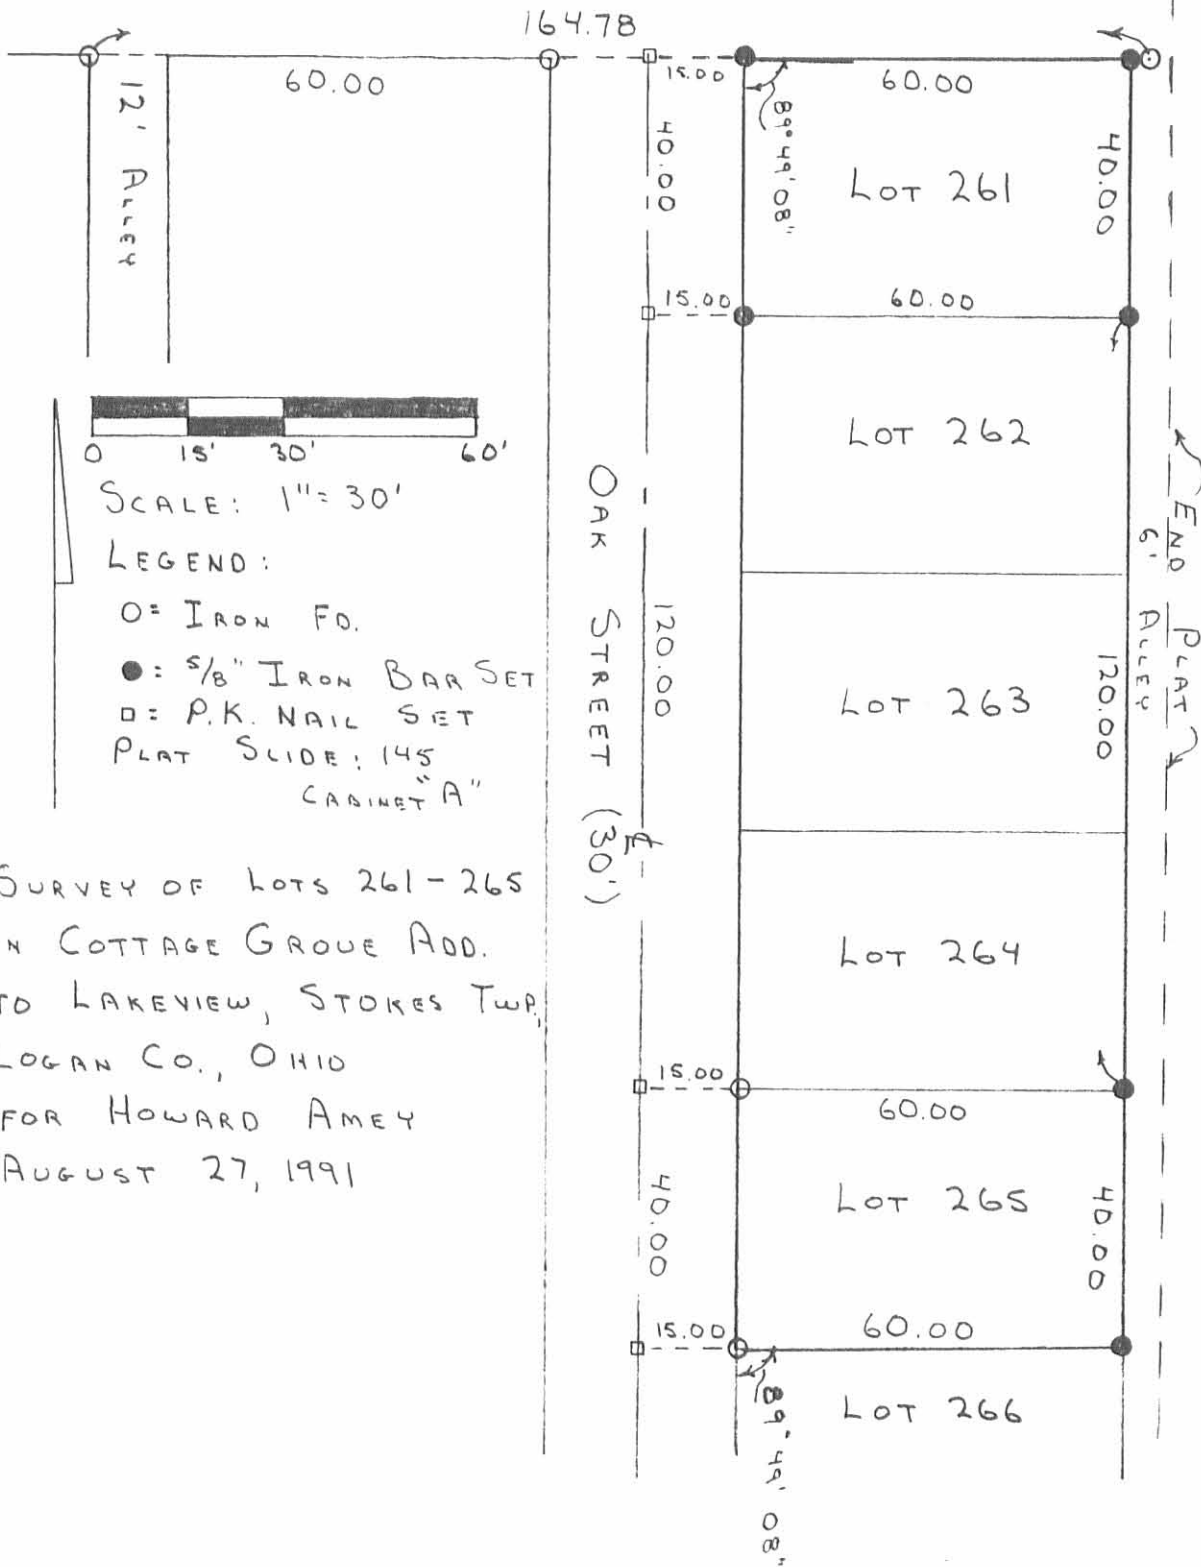

SCALE: 1" = 30'

LEGEND:

- = IRON FD.
- = 5/8" IRON BAR SET
- ◻ = P.K. NAIL SET
- PLAT SLIDE: 145
- CABINET "A"

SURVEY OF LOTS 261-265
 IN COTTAGE GROVE ADD.
 TO LAKEVIEW, STOKES TWP,
 LOGAN CO., OHIO
 FOR HOWARD AMEY
 AUGUST 27, 1991



Leslie H. Geeslin


LESLIE H. GEESLIN
 RUSHSVLVANIA, OHIO

INDEXED ON MAP
 6070 IP

n i c



N. OAK ST. - 30'

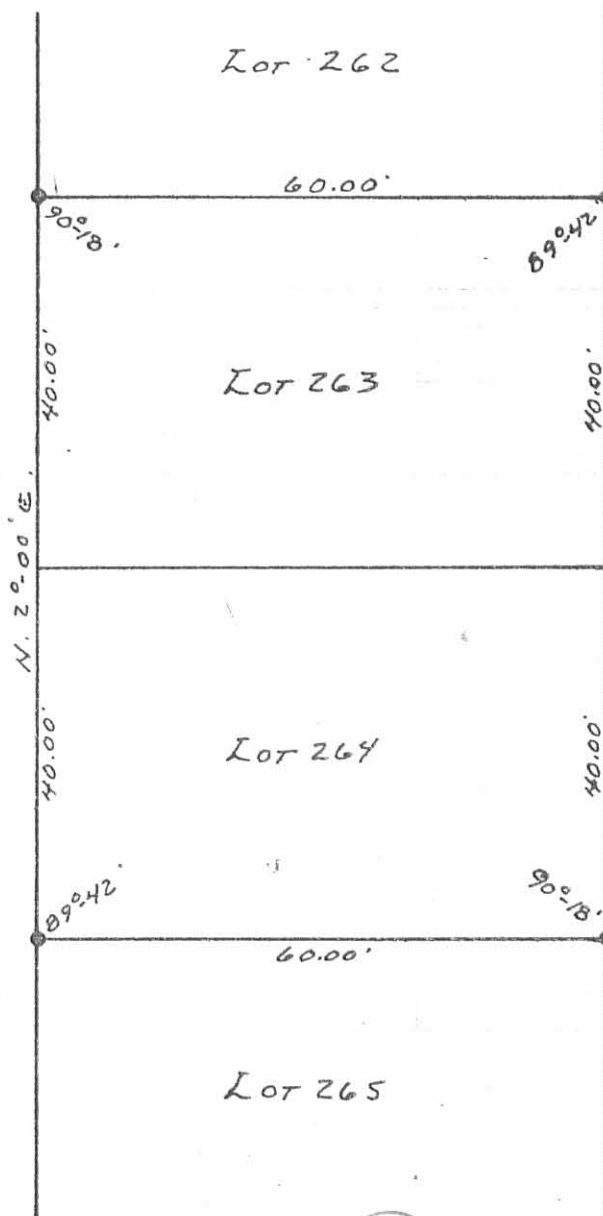

• - 5/16" IRON BARS SET.

6070 2P

INDEXED ON MAP

SURVEYED AND PLATTED BY:
 DANIEL E. GILBERT, P.S.
 REG. SUR. NO. 5402
 1041 N. MAIN ST.
 BELLEFONTAINE, OHIO 43311

SURVEY OF LOTS 263-264
 COTTAGE GROVE ADDITION
 SECTION 27 T.6S. R.8E.
 VILLAGE OF LAKEVIEW
 STOKES TOWNSHIP
 LOGAN COUNTY, OHIO
 JULY 23, 1977

SCALE: 1" = 20'