



SURVEY OF LOTS 452, 453 & PT. OF LOT 454, NICHALSON 14TH ADDITION, LAKEVIEW, OHIO FOR LARRY SCHROEDER.  
 MAY 31, 1989  
 SCALE: 1"=20'

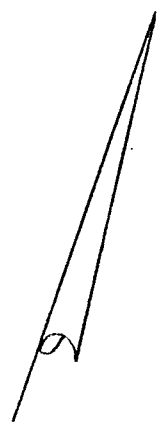

*Leslie H. Geeslin*  
 LESLIE H. GEESLIN  
 RUSHSVLVANIA, OHIO

INDEXED ON MAP  
 65.38

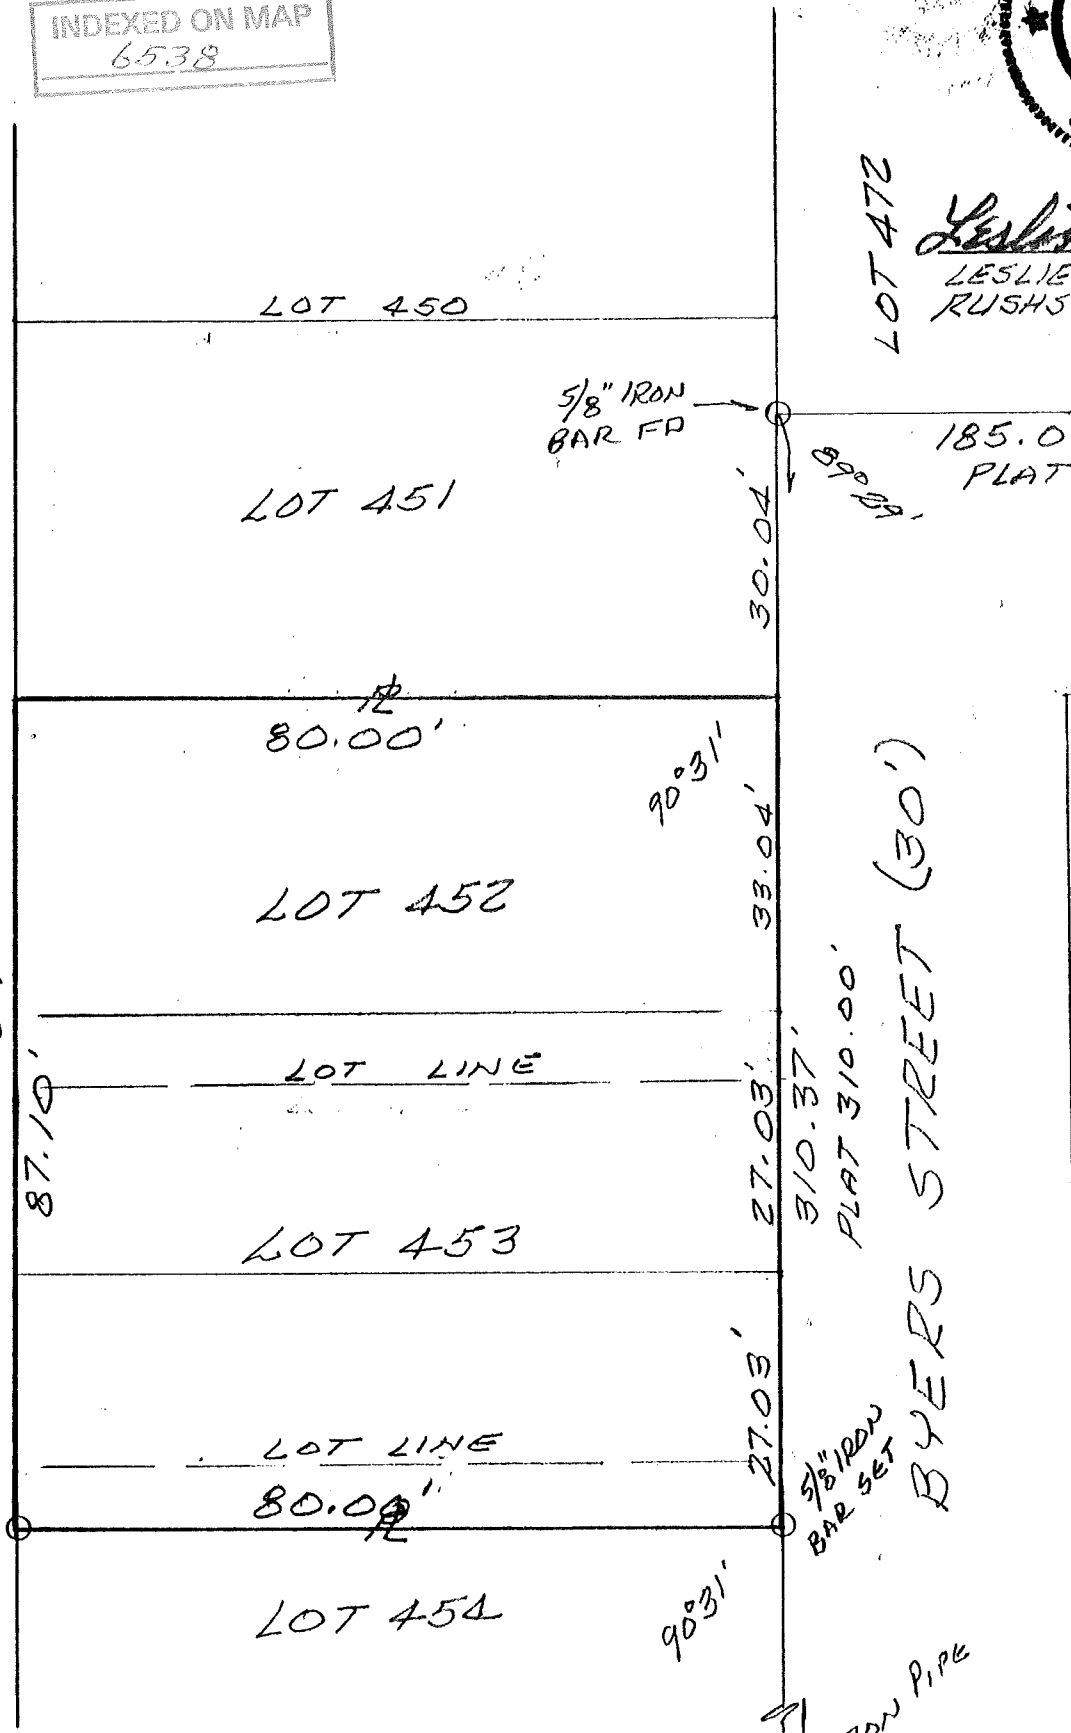


925 Byers St  
Lakewood, O  
Lots 450, 451, 472, 473, 474



6538 2P

INDEXED ON MAP

Sec Co. file 1581

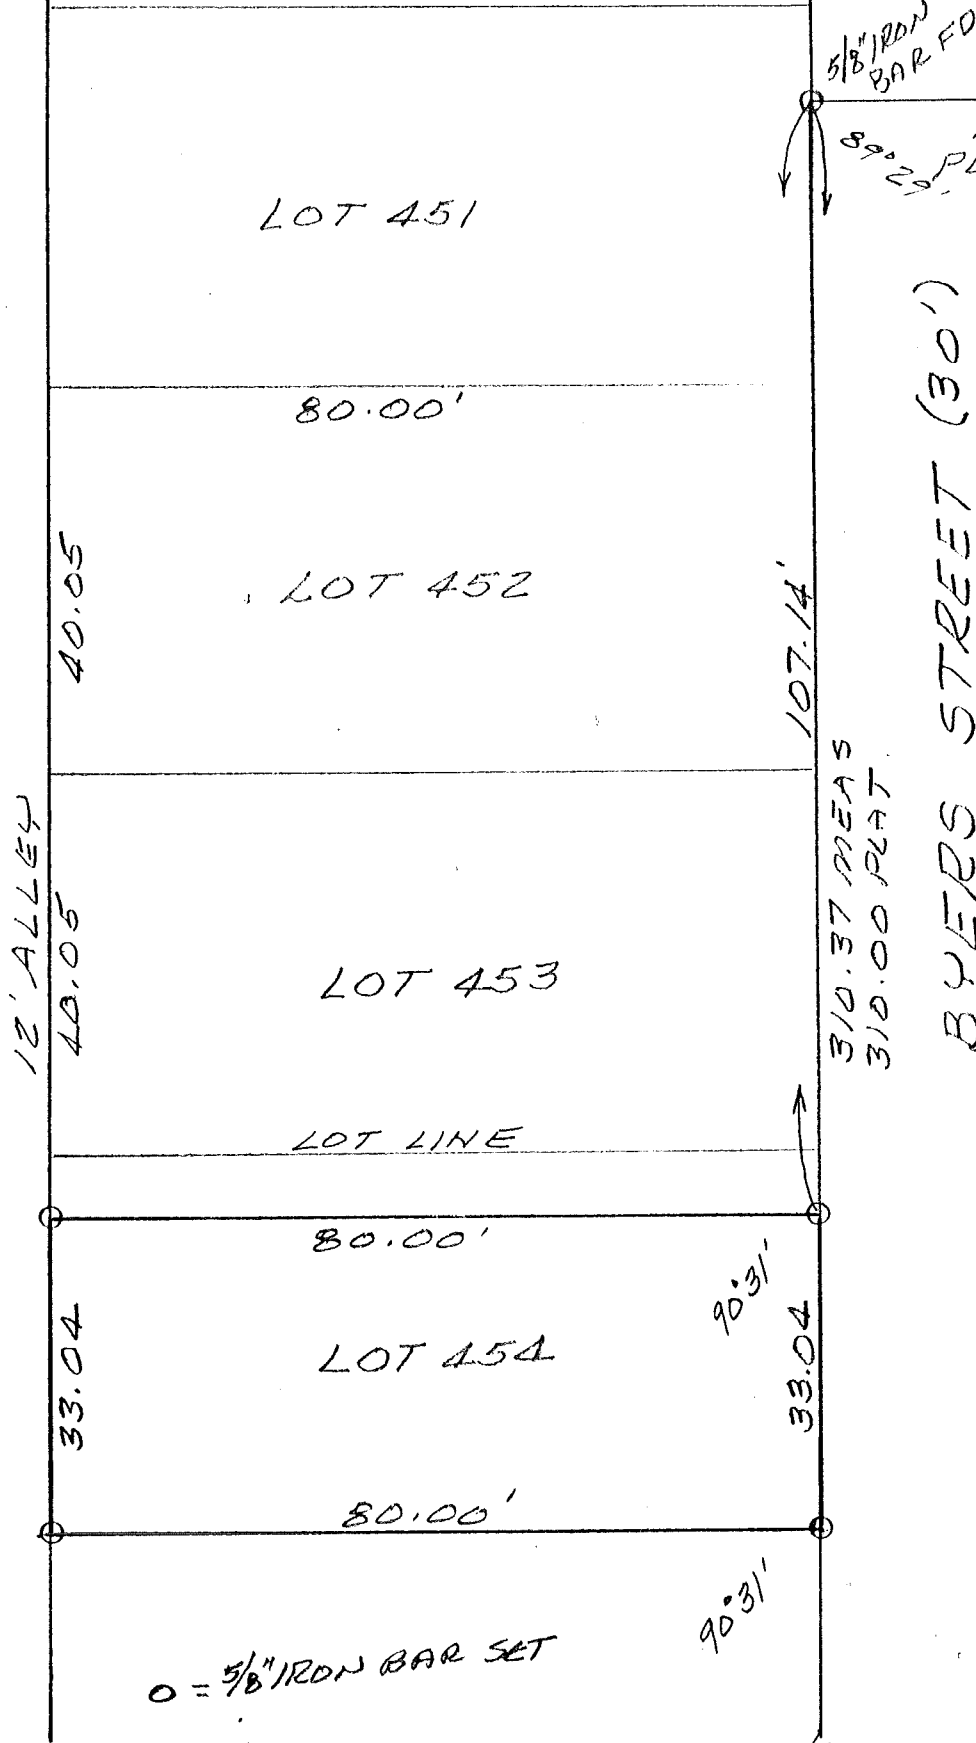

5/8" IRON BAR FD

185.03' PLAT 185.00' 89°29'

3/4" PIPE FD

LOT 451

80.00'

LOT 452

40.05

107.14'

LOT 453

12' ALLEY

40.05

310.37 MEAS  
310.00 PLAT

BYERS STREET (30')

LOT LINE

80.00'

90°31'

LOT 454

33.04


33.04

80.00'

90°31'

o = 5/8" IRON BAR SET

SURVEY OF SOUTH 33 FEET OF LOT 454, NICHOLSON & TH ADDITION, LAKEVIEW, OHIO FOR REGINA DAVIS. MAY 31, 1989 SCALE: 1" = 20'

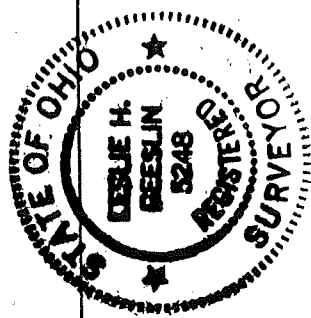

*Leslie H. Geeslin*  
LESLIE H. GEESLIN  
RUSHVILLE, OHIO

INDEXED ON MAP  
6538 IP

1/2" IRON PIPE FOUND