

STATE OF OHIO  
0.028 ACRE  
VOL. 189, PG. 495



STATE OF OHIO  
0.028 ACRE  
(0.034 AC. BY THIS SURVEY)  
CASE NO. 22172  
COMMON PLEAS COURT  
LOGAN COUNTY, OHIO

INDEXED ON MAP  
8762 1P

RETRACEMENT SURVEY OF THE  
JAMES ALLEN MINNICH  
LOT 219 AND  
THE SOUTH 10' OF LOT 220  
OFFICIAL RECORD 159, PAGE 89  
COTTAGE GROVE ADDITION  
VILLAGE OF LAKEVIEW  
STOKES TOWNSHIP  
SECTION 27, TOWN 6-S, RANGE 8-E  
LOGAN COUNTY, OHIO

LIMA STREET (30' WIDE)

LEGEND:

- 5/8" IRON ROD SET
- ⊙ 1" IRON PIPE FOUND
- 3/4" IRON PIPE FOUND


ALL IRON RODS SET ARE 5/8" x 30"  
REBAR WITH PLASTIC I.D. CAPS  
STAMPED "LEE 6359".

REFERENCES:

- 1.) PLAT OF COTTAGE GROVE ADDITION  
TO LAKEVIEW, OFFICE OF LOGAN COUNTY  
RECORDER, PLAT CABINET A, SLIDE 145.
- 2.) STATE HIGHWAY 168 RIGHT-OF-WAY  
PLANS, SECTION E, LAKEVIEW,  
SHEET 8 OF 11, ON FILE IN LOGAN  
COUNTY ENGINEER'S OFFICE, FILE L-33.

SURVEYED BY:

*Jeffrey J. Lee*  
JEFFREY J. LEE  
PROFESSIONAL SURVEYOR 6359  
NOVEMBER 23, 1992

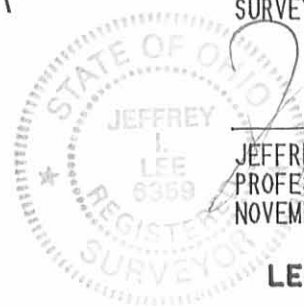

LEE SURVEYING & MAPPING CO.  
143 East Columbus Avenue  
BELLEFONTAINE, OHIO 43311  
(513) 593-7335

DISK 207

L-2051-5

LOT 220

LAKEVIEW, OHIO

Iron Found 65' Pipe Found

INDEXED ON MAP  
8762

Dodson  
Geolin

10/12/60

76

