


REC'D 9-28-98 SWY

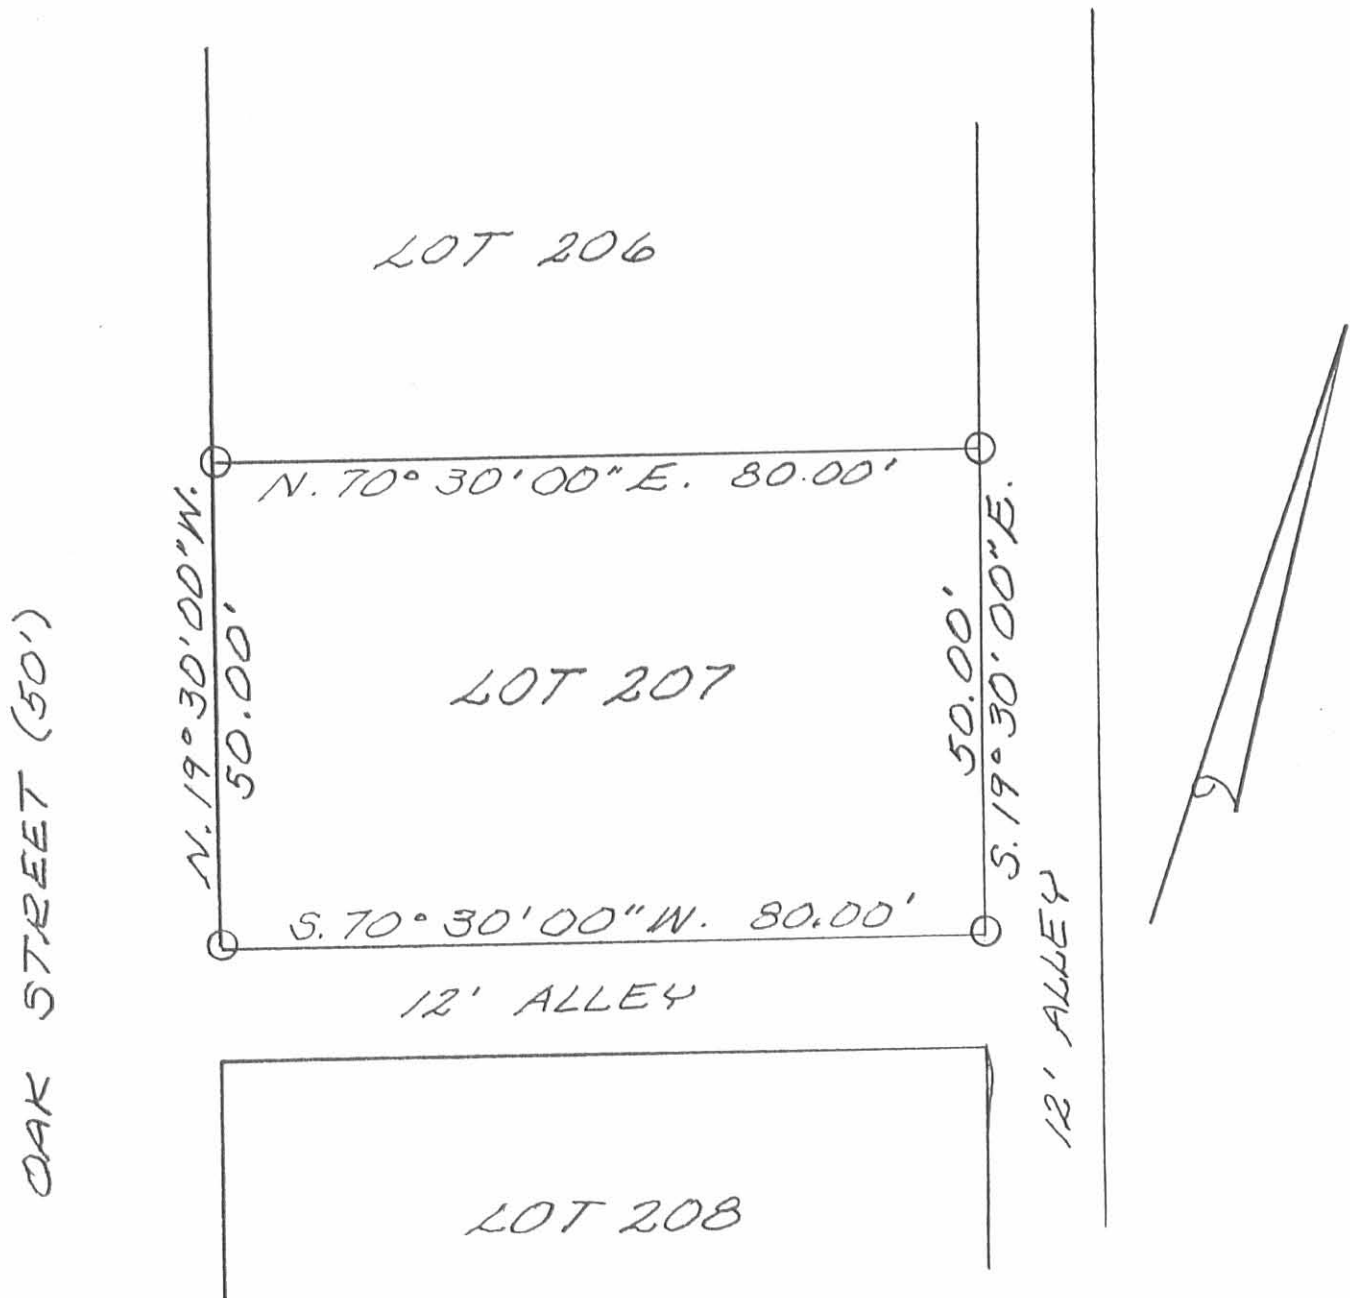

LEGEND:

○ = 5/8" IRON BAR SET


SURVEY OF LOT 207 OF MARSHALLS ADDITION TO THE VILLAGE OF LAKEVIEW, STOKES TOWNSHIP, LOGAN COUNTY, OHIO FOR TOLLIE GAMBLE.

SEPTEMBER 25, 1998

SCALE: 1" = 20'



INDEXED ON MAP
9221 1P

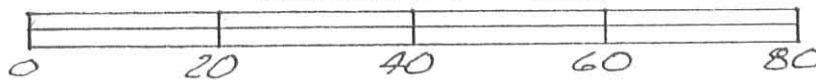

Leslie H. Geeslin
LESLIE H. GEESLIN
RUSHSVLVANIA, OH