


SURVEYED BY: *William G. Edwards*
 WILLIAM G. EDWARDS
 PROFESSIONAL SURVEYOR No. 4792
 10 SOUTH MAIN STREET
 URBANA, OHIO 43078
 (513)653-6508



INDEXED ON MAP
 9260 IP


STEPHENSON STREET (50')

OAK STREET (50')

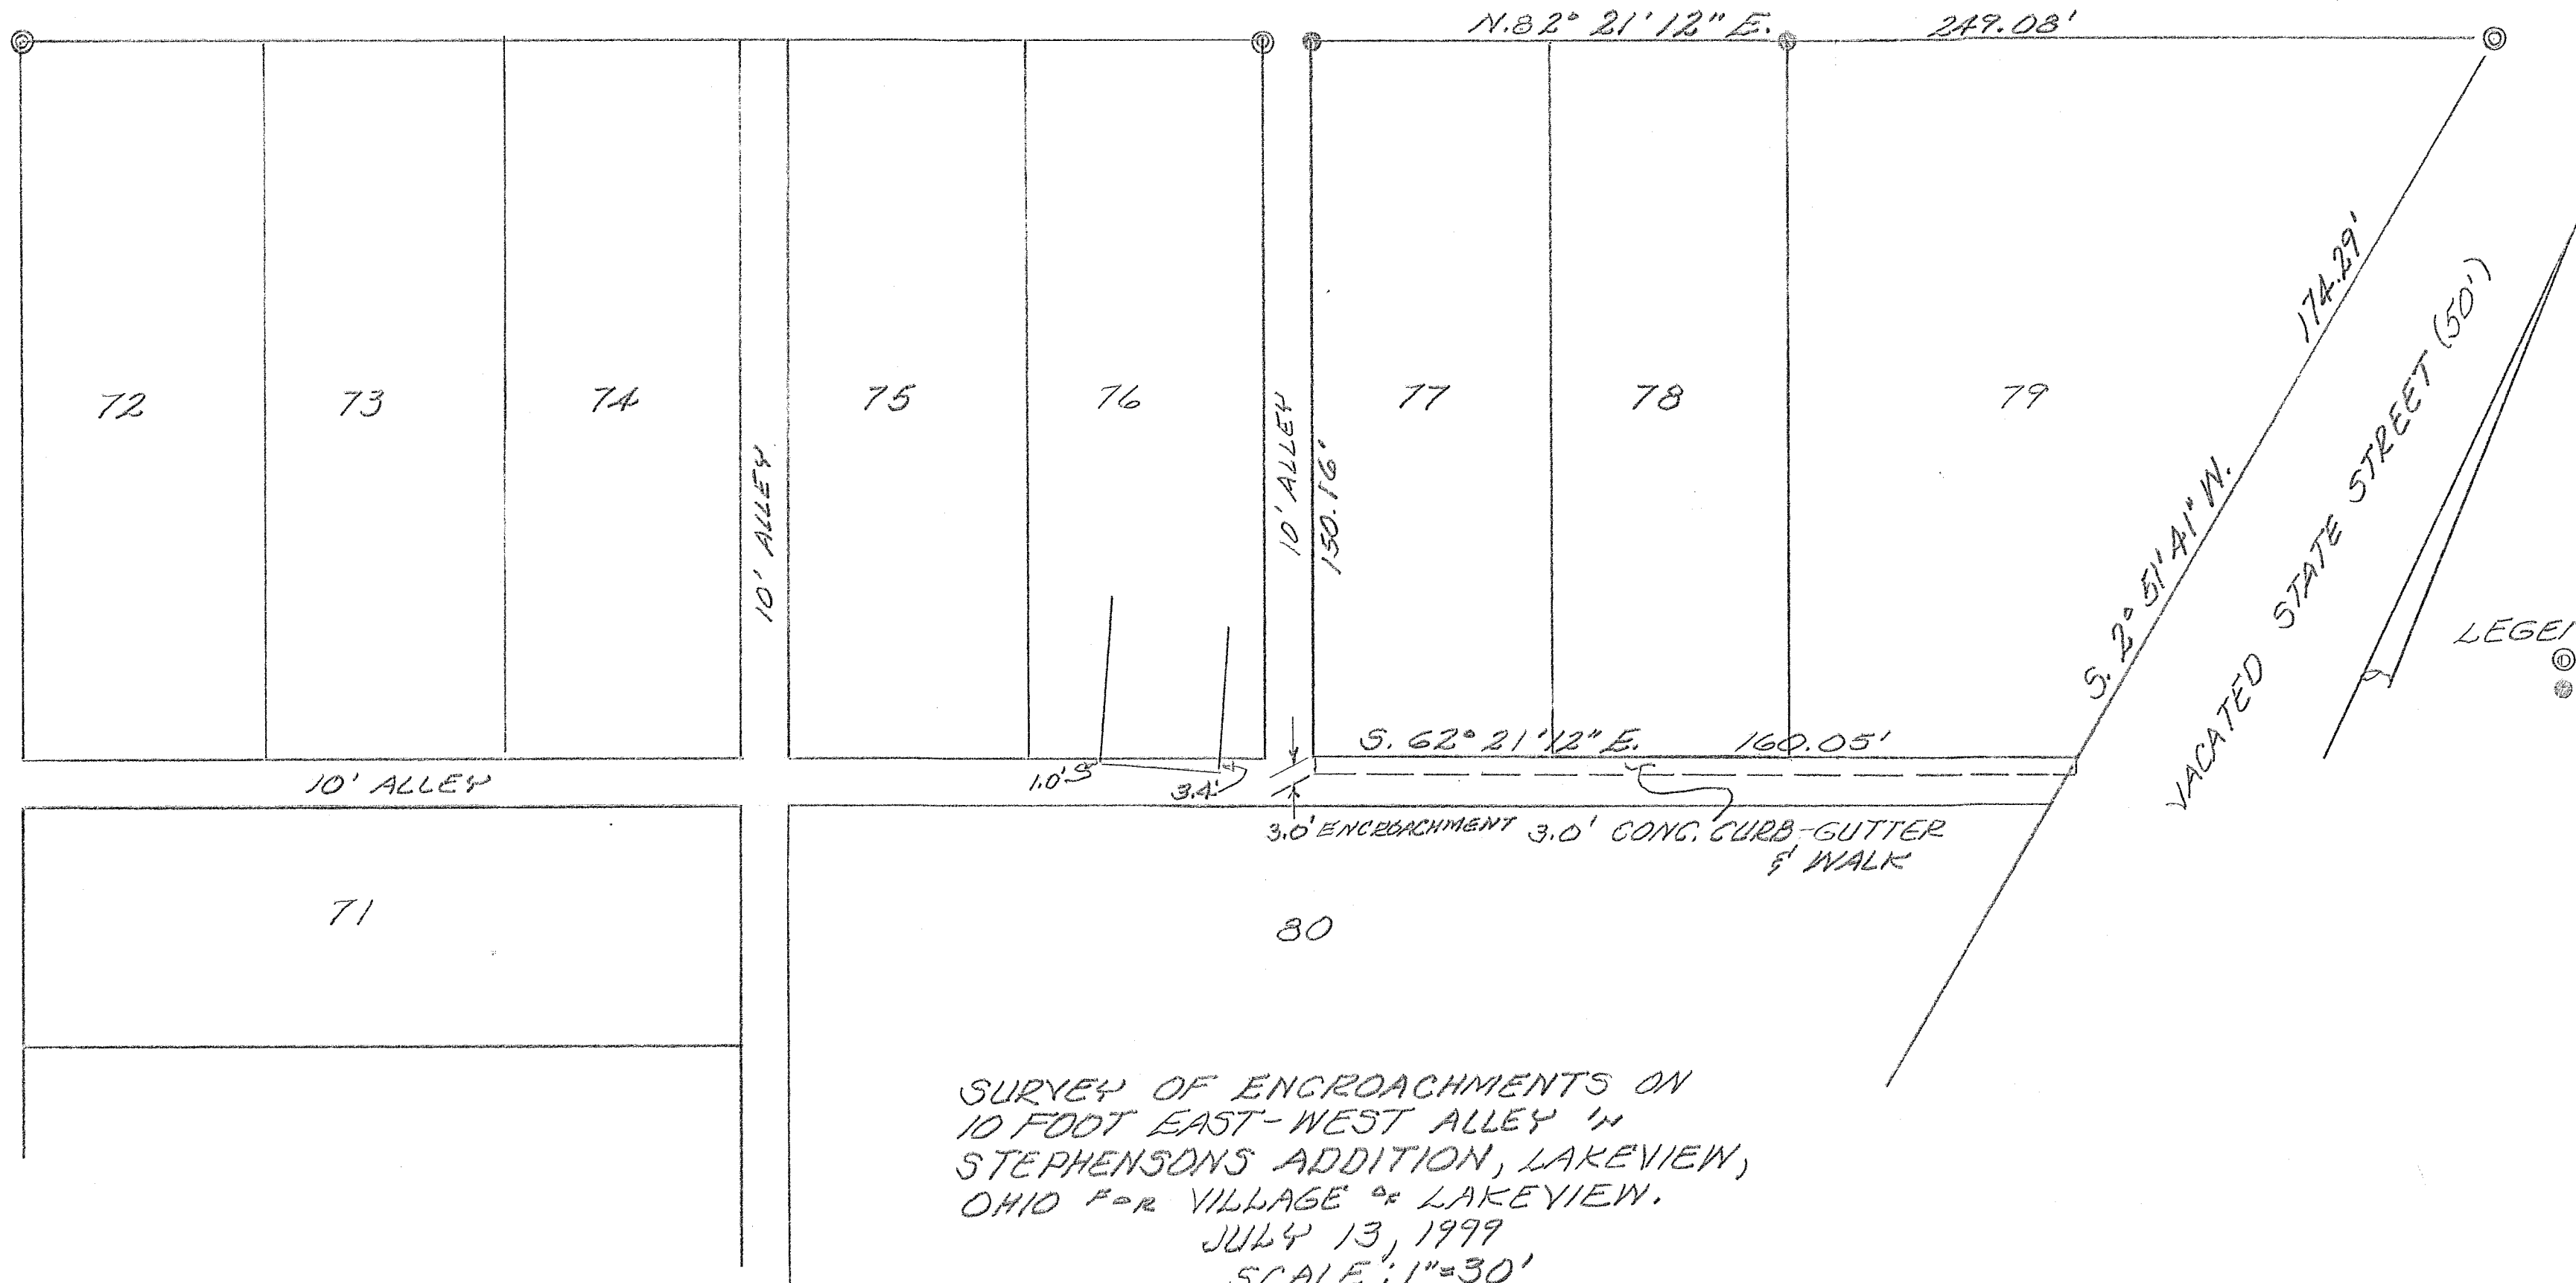

LEGEND:
 ⊙ = 3/4" PIPE FOUND
 ⊛ = 5/8" IRON BAR FOUND

SURVEY OF ENCROACHMENTS ON
 10 FOOT EAST-WEST ALLEY IN
 STEPHENSONS ADDITION, LAKEVIEW,
 OHIO PAR VILLAGE OF LAKEVIEW.
 JULY 13, 1999
 SCALE: 1"=30'

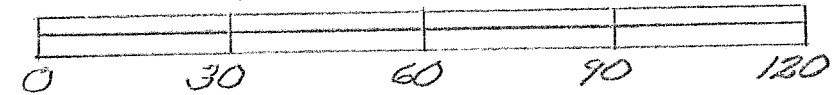

INDEXED ON MAP
 9260

Leslie H. Geeslin
 LESLIE H. GEESLIN
 RUSHsylvania, OHIO
 PH 937-468-2793