

D. Core Survey - Sec-26 Champaign Co.


- A - Center of W. Pier of Bridge 6" E of Wedge of Pier.
- F - Large Wood Post N.W. Corner of W.H. Drake's 17.25 Acre Tract.
- E - Hub in East Right of way.
- D - Concrete Post (To Be Set)
- C " " " "
- B Iron Peg in East Right of way

Note Distances from \pm between tracks and to stone were taken from R.R. map. All other distances and angles taken in field

148

INDEXED ON MAP

New exact st. L Right of way & adjacent tracks to College footbridge

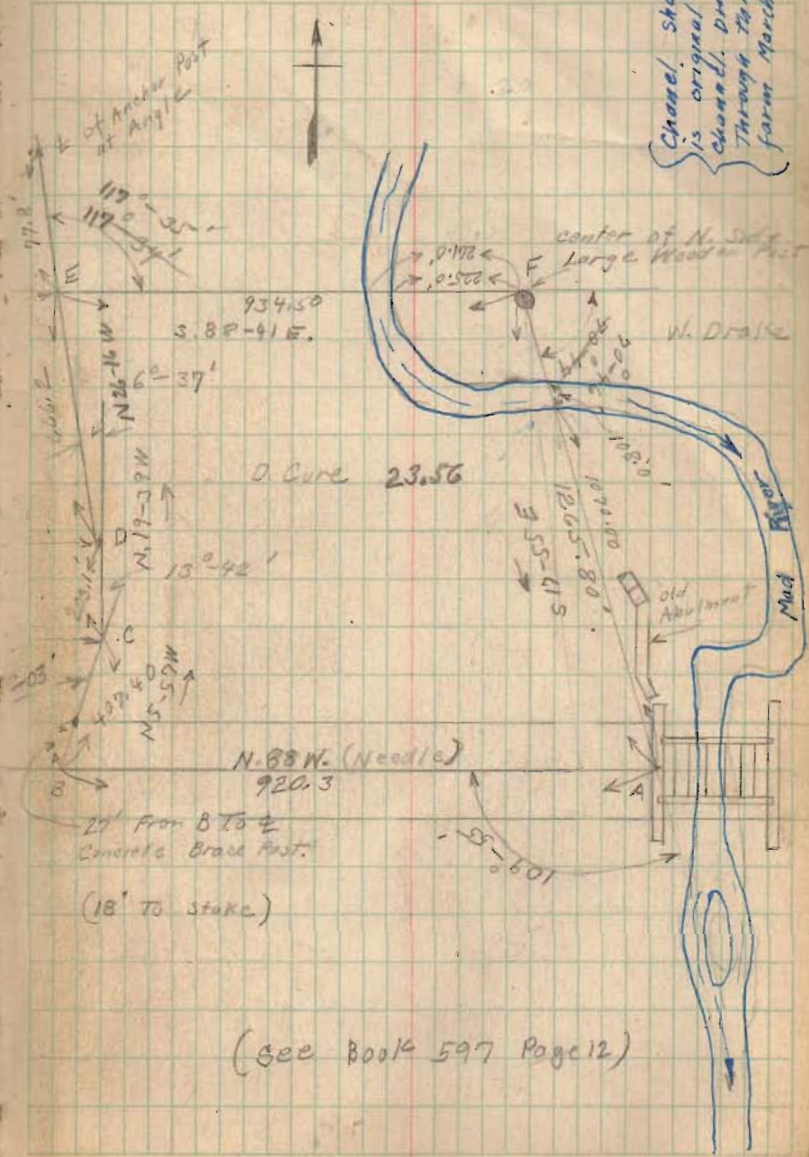

(see Book 597 Page 12)