
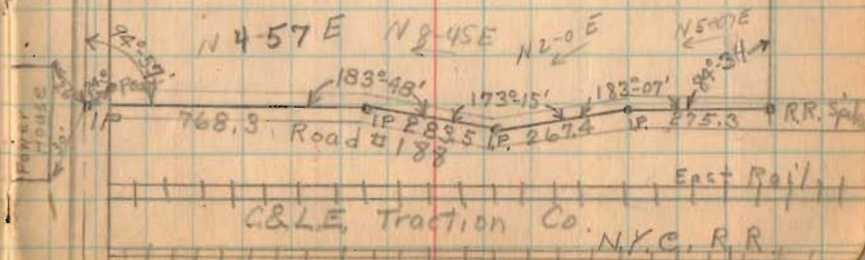


Sharp Survey
 Liberty Twp.
 5-14-36
 13

Levi Sharp Survey
 Liberty Twp.
 5-14-36
 3H. 189
 Rate 53
 8-18-31 44
 8-20-31
 Core
 Carnes
 Fultz

INDEXED ON MAP
 (1243)

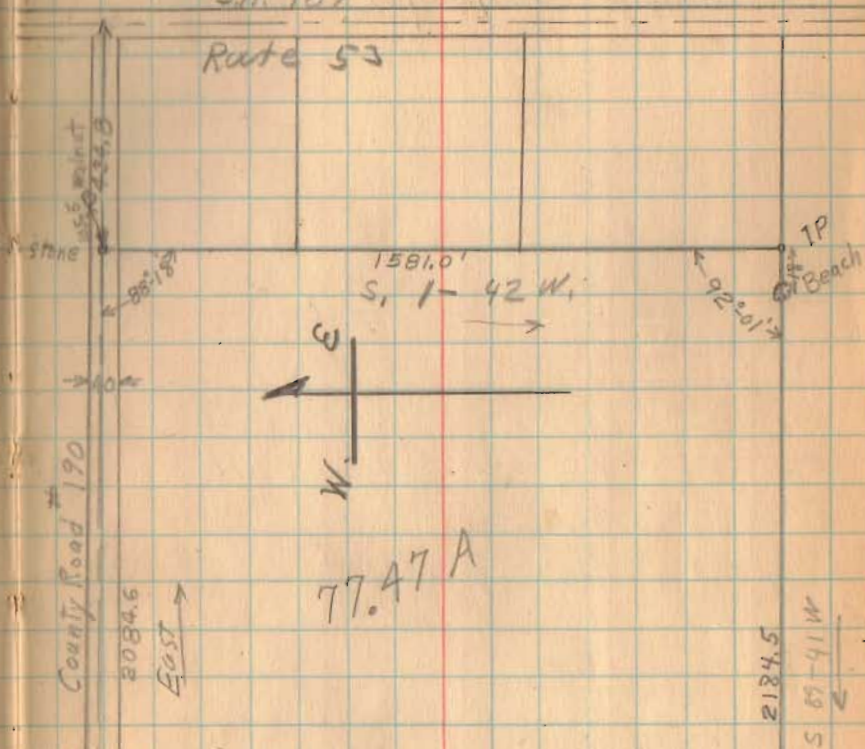

(Continued Page 44)

8-18-31

45

Sharp survey (continued)

INDEXED ON MAP

