

Road 32
Liberty Township

No record found of this road.
staked 40'


Note!-

Trustees did not use 40' as
staked. They improved road by
grading between present fences.
Corners were not cut as much
as shown.

1413
INDEXED ON MAP

July 25-1932
Clear
Wright,
McKiraan

57

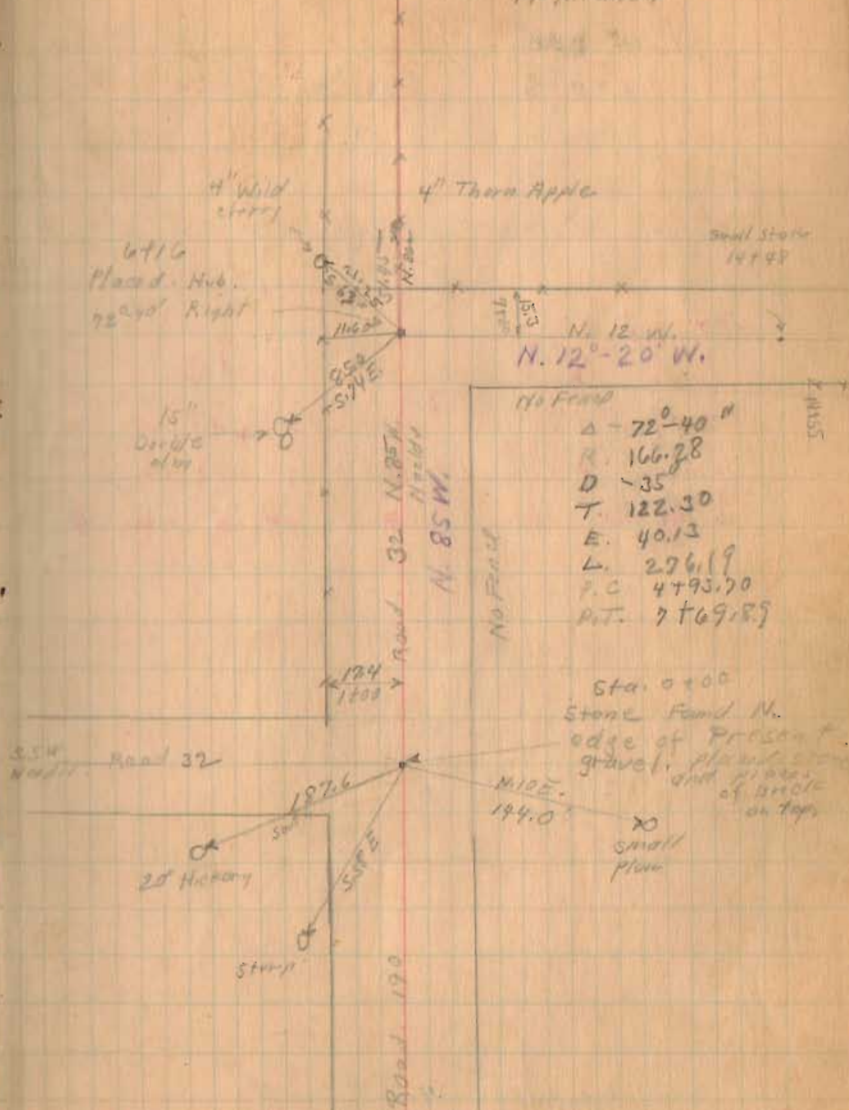

Road 32


See Note page 57

$$\begin{array}{r} 22-10 \\ 180 \\ \hline 252-10 \\ 126-05 \end{array}$$

(1413)
INDEXED ON MAP

July-26-1932
Raining
Whist
M^o Kirahon

58

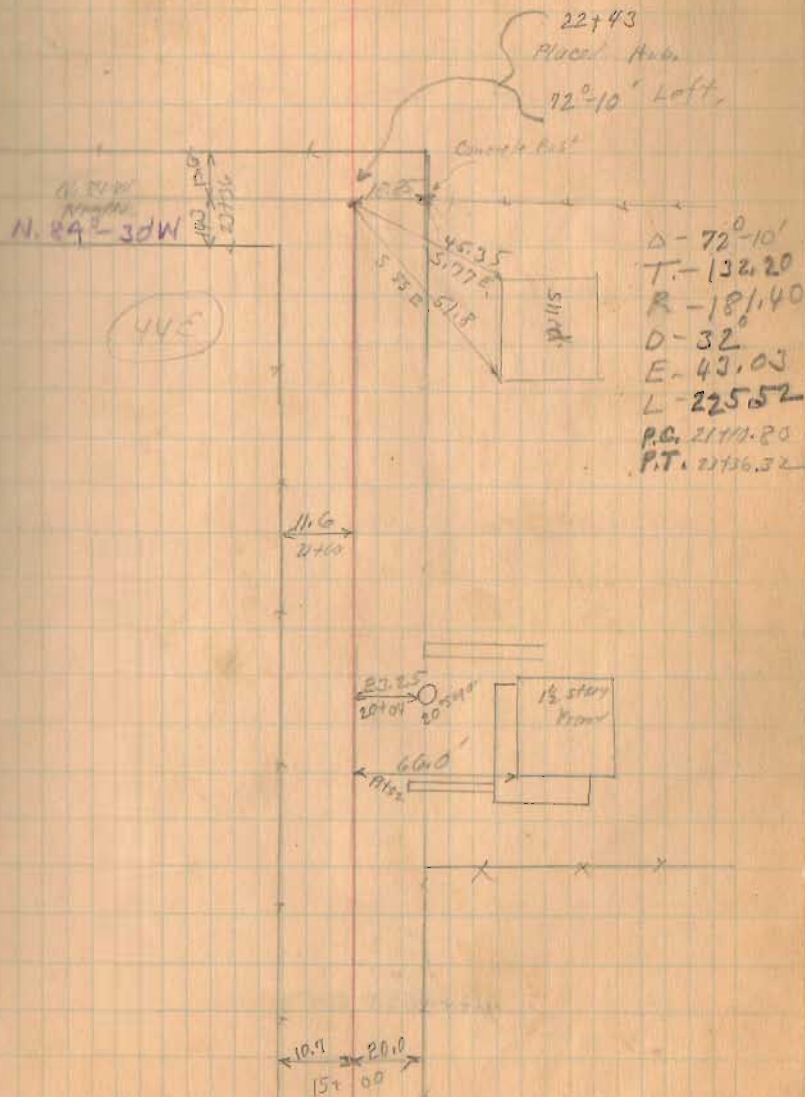

Road 32

See note Page 57

$$\begin{array}{r}
 88-32 \\
 180 \\
 \hline
 2(268-32) \\
 134-12
 \end{array}$$

1413


INDEXED ON MAP

July-27-1932

Clear

Wright
W. Kinahan

59

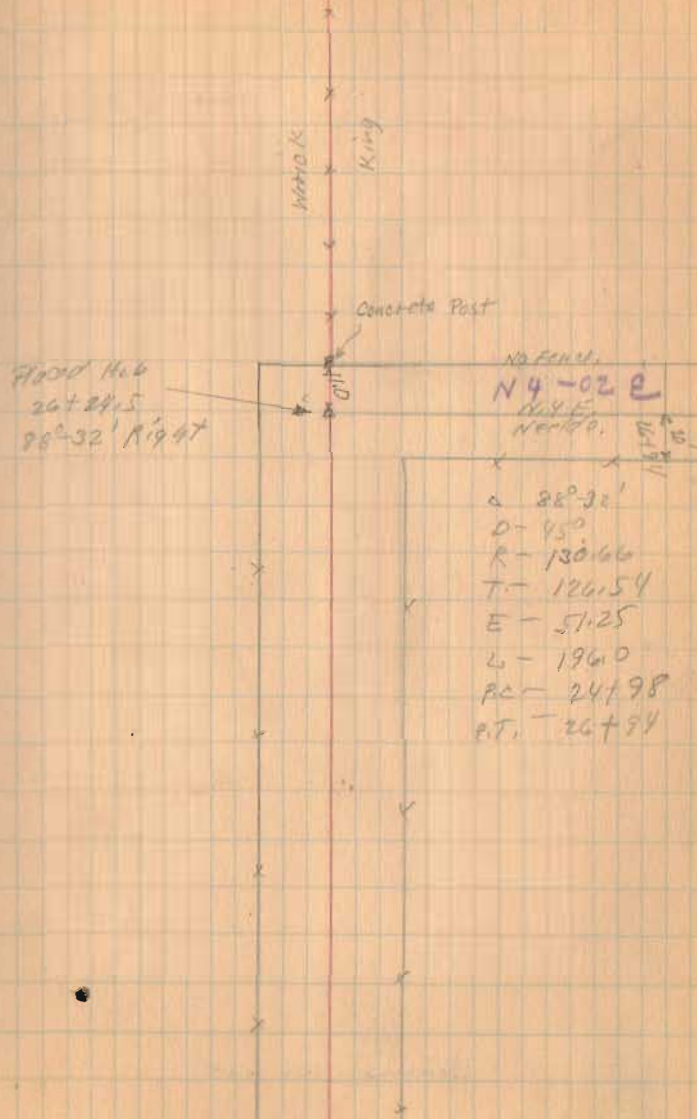

Road 32


See note page 57

180
89-20
2268-80
268-80
158-40

1413
INDEXED ON MAP


7-27-5

60

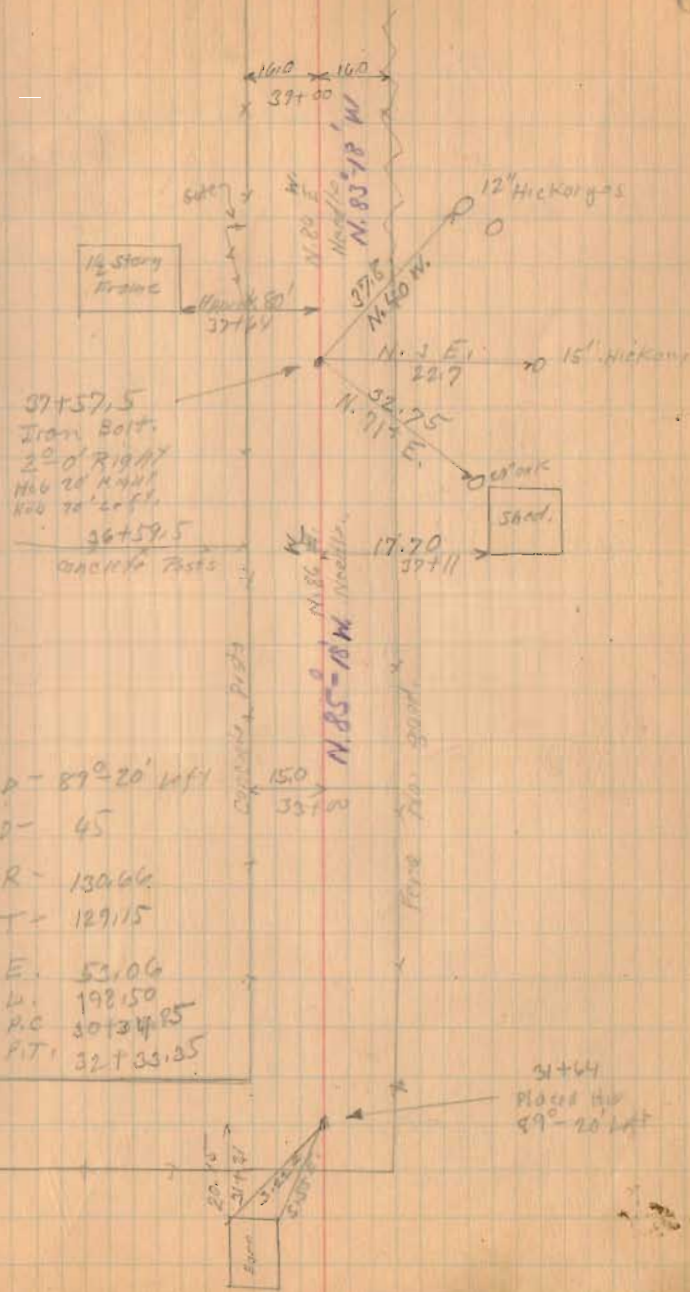

Road 32

See note page 57

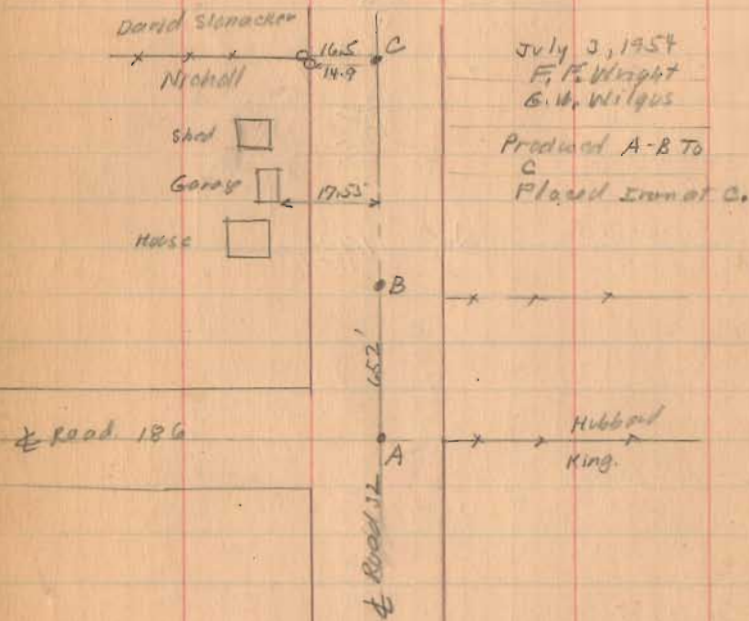

1413
INDEXED ON MAP

Line produced strikes
end of Barre of Post.



Ford 1/29/70
D.L.S.
Stone found
N. of Post
2' from

7-27-32

