

FB 692

Survey of exchange of land at
South Union Church Liberty twp

Sta. 93+06
Sec plan ~~11-189~~ DRAWER R # 3414
I.C.H. # 189 Geo. line
S.H. # 189 Route # 68

South Union Church
to
Oliver B. Byler 0.21 acre

Oliver B. Byler
to
South Union Church 1.26 acre

2041


INDEXED ON MAP

Party:
C. E. Keyser \oplus
G. M. Wilgus
D. L. Dodson \times

C. H. #
Sec. line #
191


May 17, 1951
Warm

68

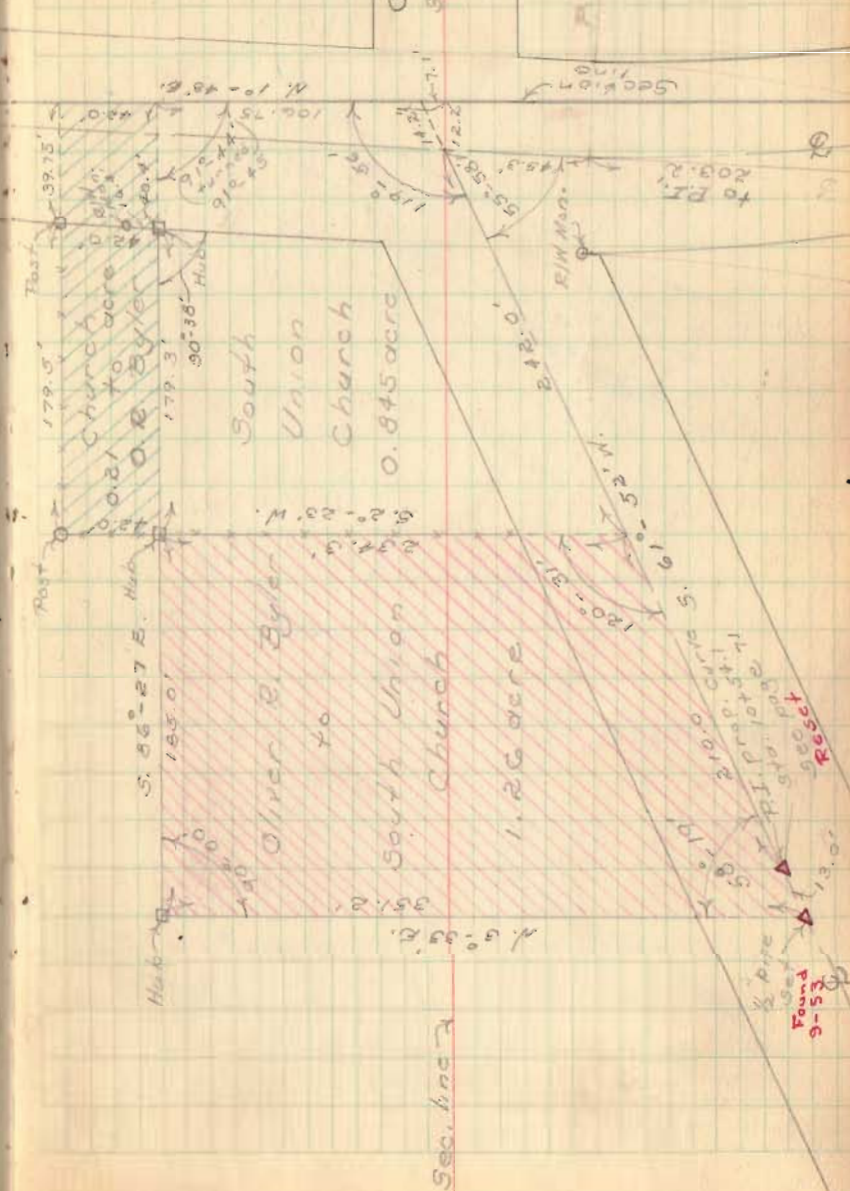

Proposed Change of C.H. #191
at South Union Church - Liberty Twp.

FB 692

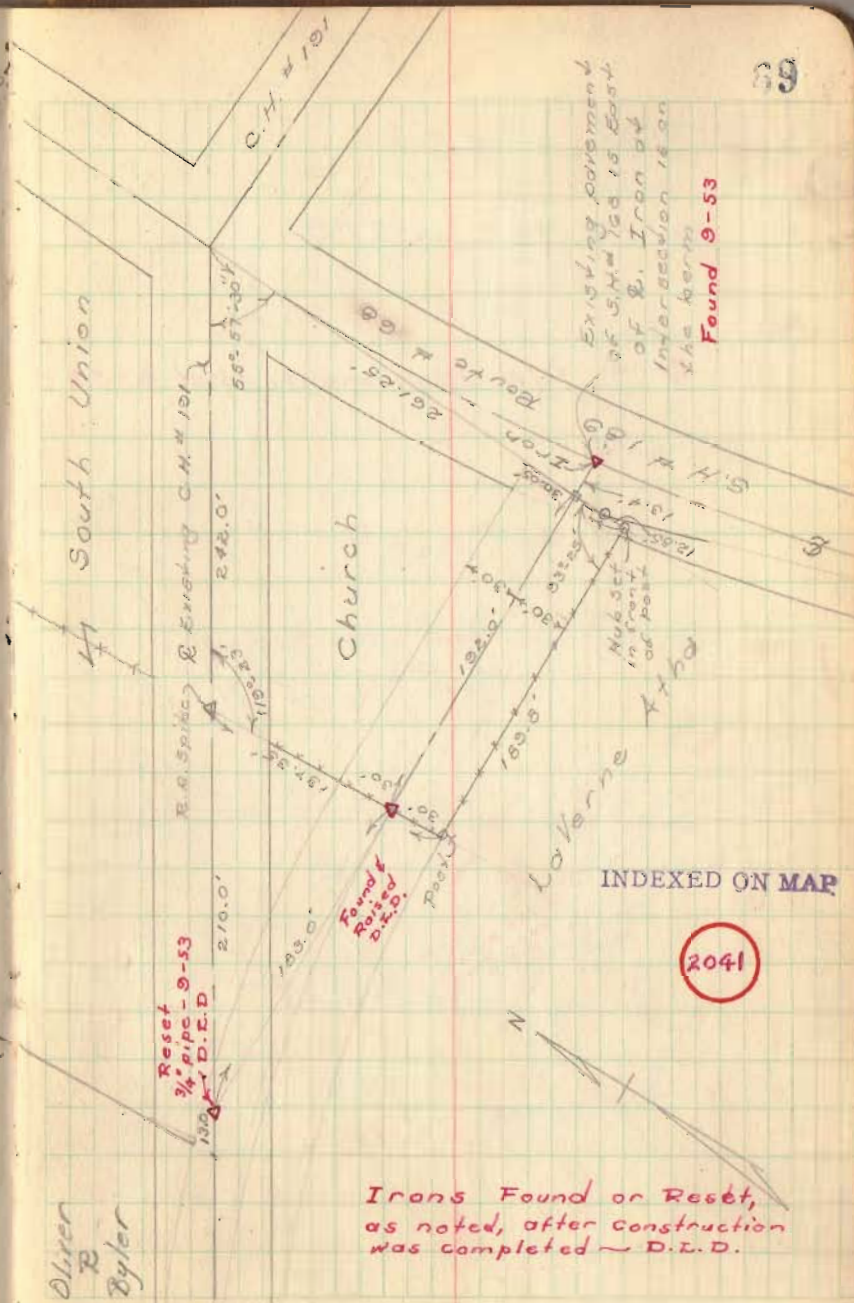


FB 692

CH #191 - Survey

Staked 60' wide

See FB 552 pg 77-8


○ = R/W Monuments set 9-53

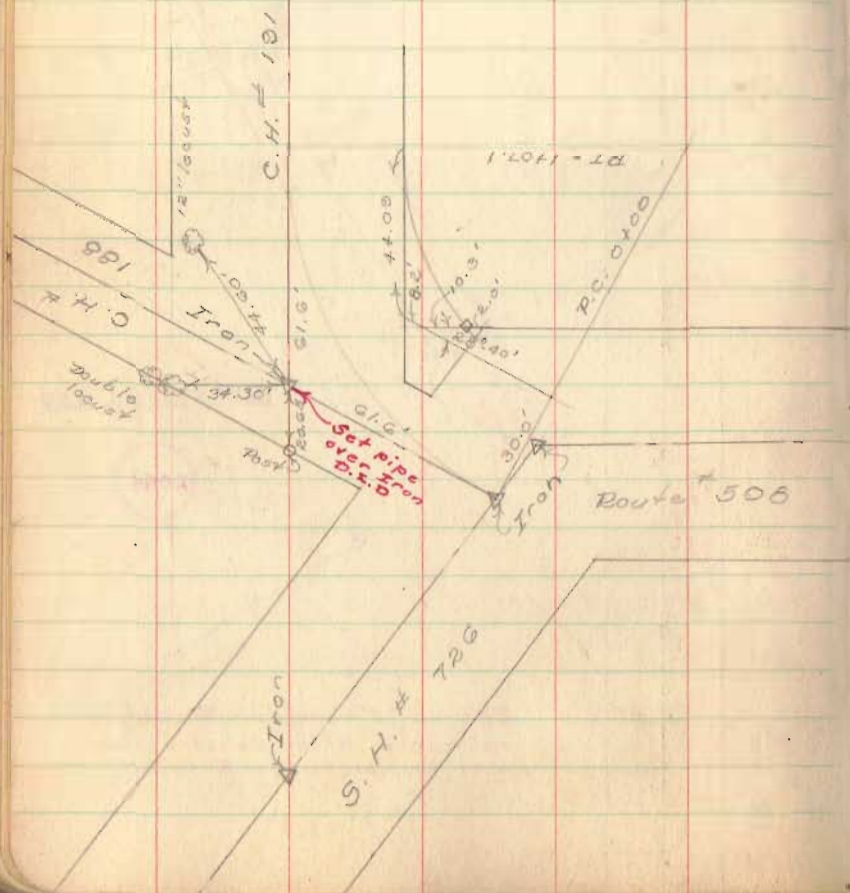

Party: - C. Kayson
D. Dalson
V. Detrick

Mar. 6, 1951

70

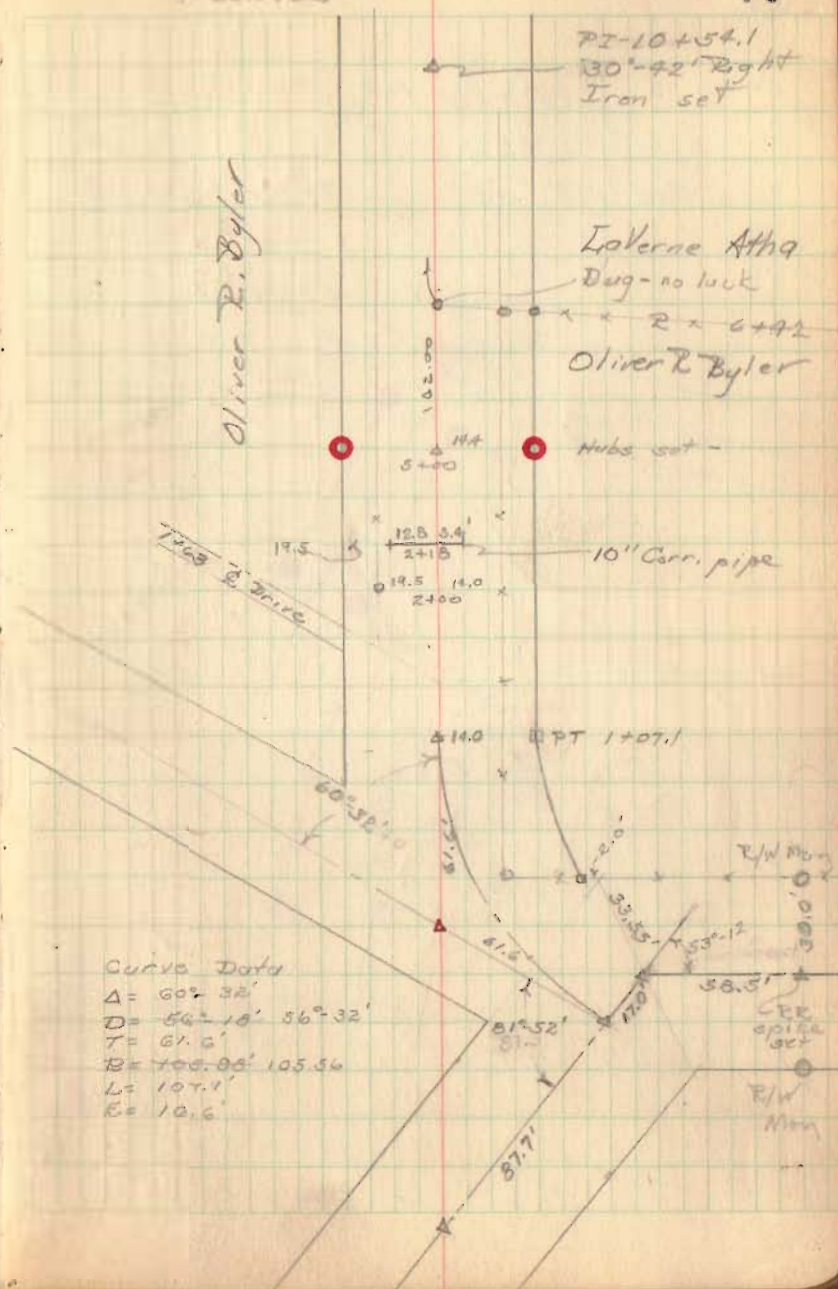

See FB 552 pg 74.

