


1/4 CORNER West of Rail Road
Road 199

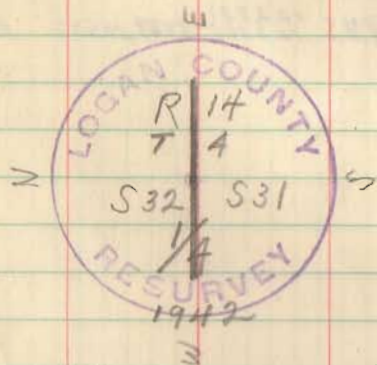


Stamped, Nov. 19 1942

R.H.R.

G.L. Inkeep
F. Hunt
R. M. Barry
9-14-42

Rd 199 - N 1/4 Cor S31 T4 R14
Found stone 8" below surface
with broken brick around
Set concrete mon. 6" below
chck top.

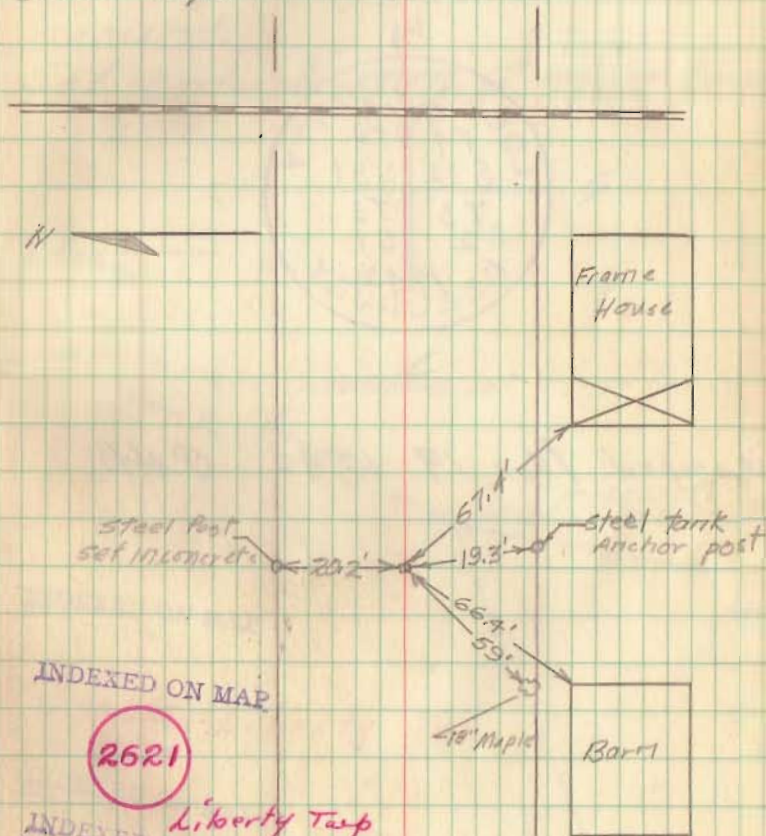

INDEXED ON MAP

2621

INDEXED ON MAP

Liberty Twp