


(14)

10-12-79 Desert
Robbins
M. Adams

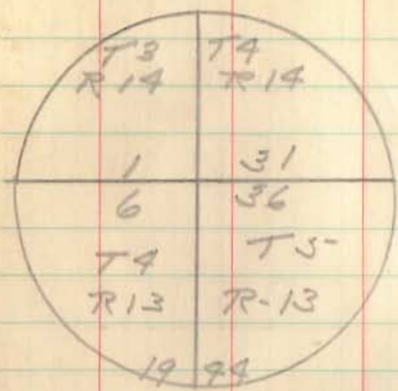

Found Stone & Brick
Removed same and placed
Con. Mon. Full length - 6" below
Surface
Marked as above

See Book 448 p. 11

87

