

KENNETH HARR SURVEY

The following described real estate situated in the Township of Liberty, County of Logan, State of Ohio and being located in Section No. 36, Town 5, Range 13, Between the Miami Rivers Survey and being a part of an original 57.640 Acre tract (now 42.070 Acres) in the name of Kenneth Harr et al as recorded in Official Record No. 267 Page 628 (9-18-1995) and now being more particularly described as follows:

Beginning for reference at a R. R. Spike set over a Pointed Stone found at the southwest corner to a 2.570 Acre tract in the name of Bruce E. Ludwig et al as recorded in Official Record No. 227 Page 925 (5-21-1994) and being Station No. 82+49.50 of the centerline survey of T. R. No. 188 as recorded in Logan County Engineers Field Book No. 519 Page 64;

Thence with the centerline of T. R. No.188, N. 10°00'00" E. 254.00 feet to a 5/8 inch Rebar found at the northwest corner to said Ludwig's tract and being the true place of beginning for this survey, (Note: The centerline of T. R. No. 188 is the Basis of Bearing for this survey - N. 10°00'00" E.);

Thence continuing with the centerline of said T. R. No. 188, N. 10°00'00" E. 200.00 feet to a R. R. Spike set;

Thence S. 79°09'00" E. 384.75 feet to a 5/8" x 30" Rebar set, passing through a 5/8" x 30" Rebar set at 20.00 feet;

Thence S. 10°55'00" W. 200.00 feet to a 5/8" x 30" Rebar set in the north line of Ludwig's tract;

Thence with the north line of Ludwig's tract, N. 79°08'50" W. 381.54 feet to the true place of beginning, passing through a 5/8" x 30" Rebar set at 359.89 feet, containing 76,620.330 square feet or 1.759 Acres, more or less.


Of the above described tract, there is 3,000.00 square feet or 0.069 Acres in the right of way of T. R. No. 188.

I hereby certify that this description is the result of a field survey made by me on April 20, 1998.




Daniel E. Gilbert
DANIEL E. GILBERT, P.S.
REG. SUR. NO. 5402
400 N. PARK ST.
BELLEFONTAINE, OHIO 43311
TELEPHONE: 1 (513) 593-1428

INDEXED ON MAP
2922 10

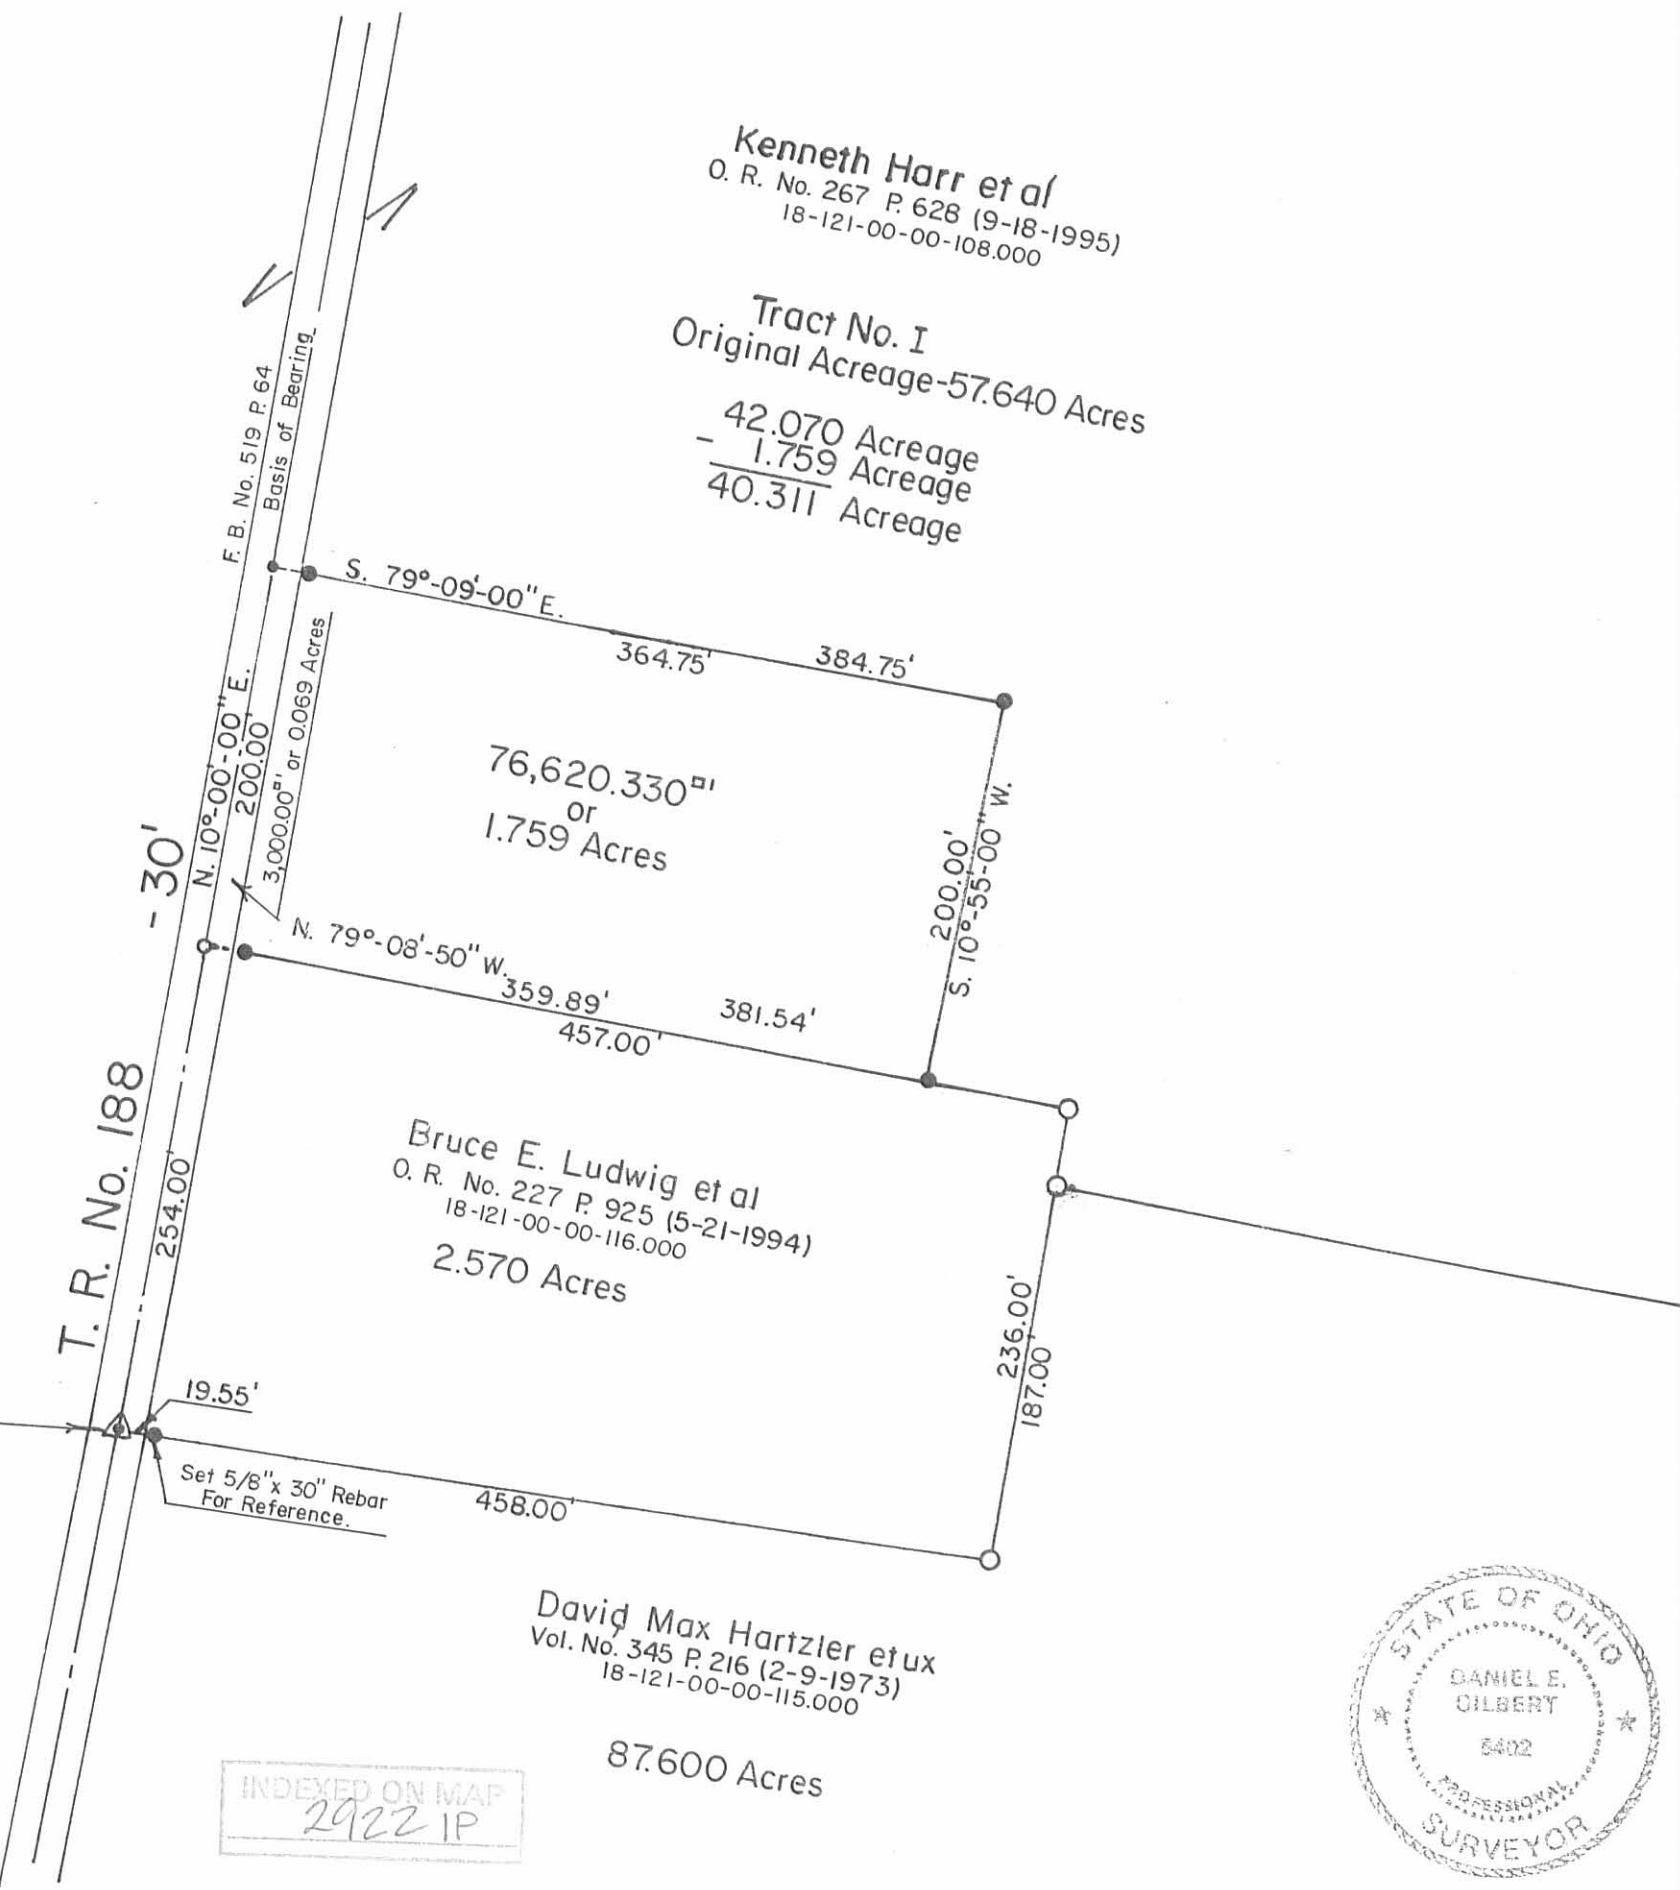

INDEXED ON MAP
2922 IP

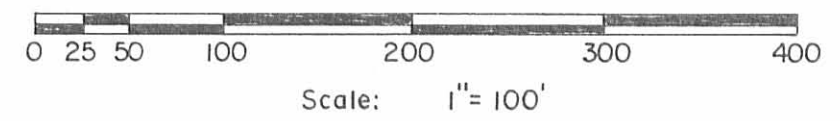

- SYMBOLS:**
- - R. R. Spikes Set.
 - - 5/8" Rebar Fd.
 - - 5/8" x 30" Rebars Set.
 - - Wood Corner Posts Fd.

KENNETH HARR SURVEY Section No. 36 Town 5 Range 13 B.M.R.S. Liberty Township, Logan County, Ohio.		
SCALE: 1" = 100'	APPROVED BY:	DRAWN BY DEG
DATE: 4-20-1998		REVISED
<i>Daniel E. Gilbert</i> Daniel E. Gilbert, P.S. Reg. Sur. No. 5402		DRAWING NUMBER 098-009

Harr Survey Liberty Twp. March 1951 2.57 Acres

The following described land in Liberty Township, Logan County Ohio and being in Section 36 Town 5 Range 13

Beginning at an iron in the center of County Road Number 188 at the N.W. corner of B.Leonard Ypder's 100.86 acre tract and said iron being Station 82 plus 49.5 of said Road Number 188 as shown in Logan County Engineer's Field Book 519 Page 64 thence with the center of Road Number 188 N. 3° - 48' E. 254.00 feet to an iron pipe thence S. 85° - 17' E. 457.00 feet to an iron pipe thence S. 3° - 34' W. 236.00 feet to the South side of a large wood post the last described line passing a wood post at one of B.Leonard Yoder's N.W. corners at 49.00 feet thence with the North line of said Yoders land N. 87° - 36' W. 458.00 feet to the place of beginning said tract containing 2.57 acres.

cc
E.K.Core,
Logan County Engineer

INDEXED ON MAP

2922

2D

March 10 1951
Cool
F.F. Wright
Grover Witkos

Viberty Twp.

W. Wallace Kauffman

56.64
- 2.57

54.07

⊕ Road 249

Road 188



Barn

S. 85-17E

457.00



8' cedars



2.57 ACRES

N 87-36 W.

S. 3-34 W.

Wood Post

49.00

187.00

236.00

Wood Post

19.60

458.00

Wood Post

Pipe

Pipe

N. 3-48E

254.00

8' cedars

88-36



New Wood Post

19.60

458.00

Pipe sta.
82 + 49.5
Co. Eng. BULK
519 Page 64

B. Leonard Yoder
100.86 Acres

(No. scale)

INDEXED ON MAP
2922 ZP