

Lee Surveying and Mapping Co.



CLAYTON M. LEE, P.S.
JEFFREY I. LEE, P.S.

855 East Sandusky Avenue
Bellefontaine, Ohio 43311
Phone 593-5780



Farm Surveys • Lot Surveys • Topography • Subdivisions • Construction Layout

EARICK TO THOMAS

Lying in Section 25 and 31, T-4, R-14, B.T.M., Liberty Township,
Logan County, Ohio.

Being out of that land lying in the name of Steven Earick as deeded
and described in Volume 402, Page 876 of the Logan County Records of Deeds
and lying adjacent to and abutting on the east side of that 0.50 acre (Vol-
ume 404, Page 547) and also abutting the north line of that Thomas tract in
Volume 381, Page 87 (1.564 acres). Being more particularly described as
follows:

Beginning at an iron rod found marking the northeast corner of said
1.564 acre tract.

THENCE, with the north line of said 1.564 acre tract, N 86°-01' W, a
distance of 120.56 feet to an iron rod found at the southeast corner of
said 0.50 acre tract.

THENCE, with the east line of said 0.50 acre tract, N 4°-10' W, a
distance of 85.00 feet to an iron rod set at the northeast corner of said
0.50 acre tract.

THENCE, with the north line of said 0.50 acre tract extended,
S 86°-01' E, a distance of 120.56 feet to an iron rod.

THENCE, parallel to the west line, S 4°-10' E, a distance of 85.00
feet to the point of beginning.

Containing 0.233 acre of which 0.210 acre is in Section 25 and 0.023
acre is in Section 31.

Prepared by:

Clayton M. Lee

Clayton M. Lee
Registered Surveyor No. 6181
October 1, 1984
REV. 10-22-84



7220 ID

INDEXED ON MAP



ORIGINAL STAMP IN GREEN

L-237

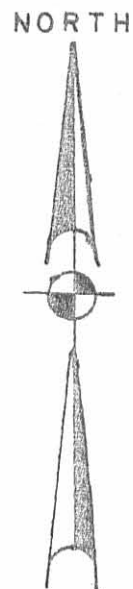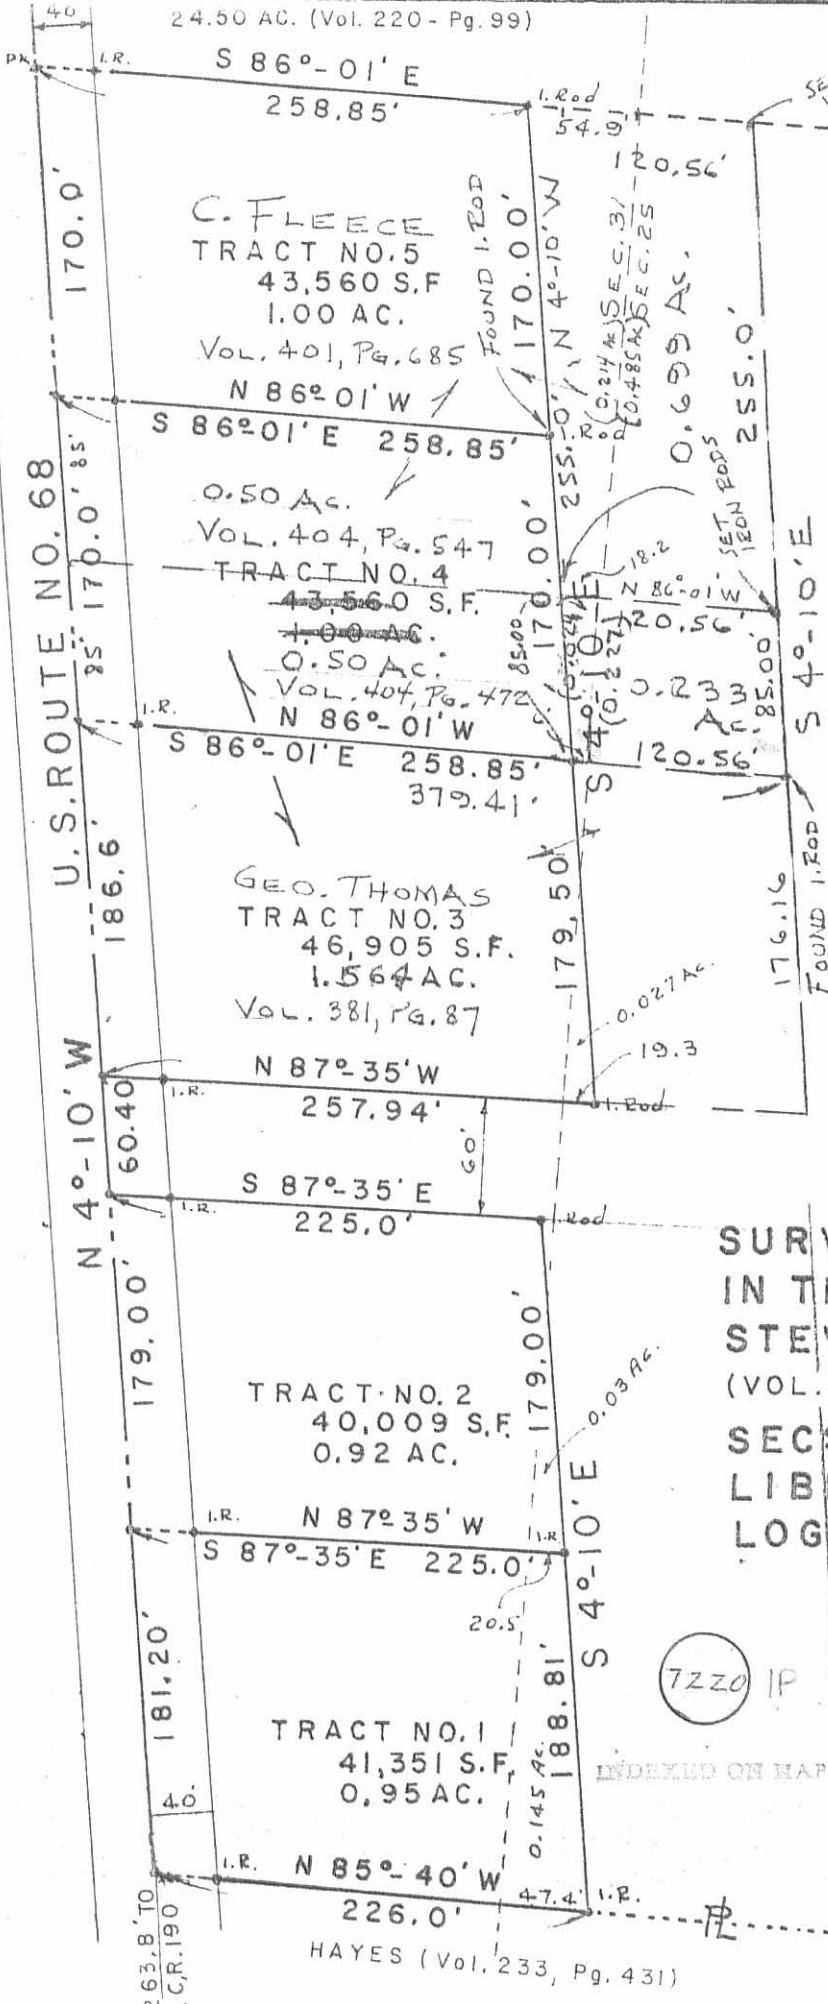

STEVEN EARICK
VOL. 402, PG. 876

SCALE 1"=100'



**SURVEY OF 2 TRACTS
IN THE LANDS OF
STEVEN EARICK
(VOL. 402, PG. 876)
SECS. 25 & 31, T-4, R-14, ~~M.P.S.~~ B.T.M.
LIBERTY TOWNSHIP
LOGAN COUNTY, OHIO**

SURVEYED BY:
Clayton M. Lee
Clayton M. Lee
Ohio Reg. Surveyor 6181

3-15-77
REV. 9-22-84

Lee Surveying & Mapping Co.
855 E. Sandusky Ave.
BELLEFONTAINE, OHIO 43311
(513) 593-5780

7220 IP

INDEXED ON MAP

HAYES (Vol. 233, Pg. 431)