


May 15th (mo.) 19 1823

Survey No. 16

(817)

I made the following survey for Nicholas Pickrell who presented to me a certificate from Croak & Collock Auditor of Logan County bearing date at Bellefontaine March 10th 1823 and certifying that there was that day fifty acres of land sold to Nicholas Pickrell for the sum of \$8.59.6, the tax interest and penalty for the years 1820 & 21 with the tax of 1822 (on) being part of a tract of land entered for taxation in the name of William Hunt by of south west quarter of Section 31 in Town 4 & Range 14, to be laid off by meter and bounds by lines parallel with the lines of the tract in as near a square as practicable. — Whereupon I proceeded to lay off fifty acres in a square in the north-west corner of the ~~S.W.~~ ^{N.W.} ~~qr~~ of said Sec. beginning the northwest corner of the south west qr. of said sec. a white oak 14 inches in diam. $N 53^{\circ} E$ 29 links dist.

thence east 89.5 poles a white oak 12 inches in diam. $S 28^{\circ} 35'$ links dist. thence south 89.5 poles to a white oak 24 inches in diam. $S 32^{\circ} W$ 31 links dist. thence west 89.5 poles to a stake in a prairie and in the original line, thence with said line north $\frac{1}{2}$ (variation) 89.5 poles to the beginning containing fifty acres

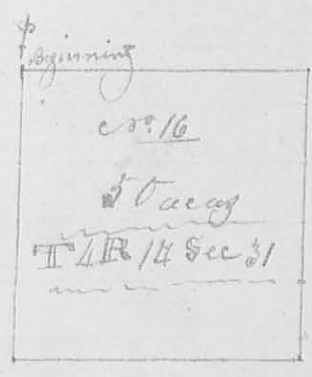


Jas. McHarron Surveyor

7th mo (July) 12th 1823

Survey No. 17

Surveyed for the Society of Friends; beginning at a stone and dog wood and dog wood north westerly corner to a lot of ground sold by Martin Marmon to said Society and north westerly corner to a lot of land conveyed by Duncan McArthur to said Marmon thence with the north line of said lot of land

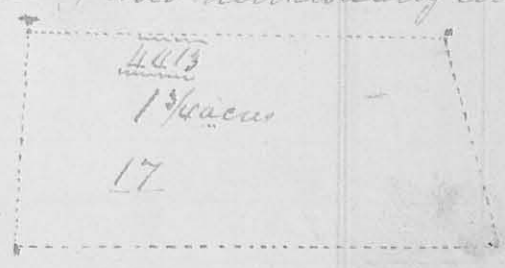

$S 75^{\circ} E$ passing a stone at 25 1/2 poles, easterly corner to Duncan McArthur's survey $N 44^{\circ} 31'$ 25.8 poles to a stone, thence north 12 poles to a stone. Thence $N 75^{\circ} W$ 22 poles to a stone red hick ash and white oak in the easterly line of Martin Marmon's land thence with said line $S 15^{\circ} W$ 12 poles

320

No. 950

(8179)

Survey Sept. 18. 1840 for David Gwynne the
 NW qtr. of the SW quarter of T. 3 R. 14 and as follows.
 Beginning at the NW corner of said quarter section at
 a Stone center of the West line of the section & SW corner
 to ~~the~~ ^{the} ~~west~~ ^{west} ~~line~~ ^{line} ~~of~~ ^{of} ~~the~~ ^{the} ~~section~~ ^{section} ~~of~~ ^{of} ~~80~~ ⁸⁰ ~~acres.~~ ^{acres.} Thence with ^{the} ~~the~~ ^{line} ~~line~~ ^{of} ~~the~~ ^{the} ~~section~~ ^{section} South line
 S 89° E 20 chain 62 links to a Bur Oak 5 Inches diam at
 N 43° W 21 links, and a Bur Oak 4 I. D. N 71° E 13 links
 thence S 1° W 20 chain to a ~~White~~ ^{White} Oak 6 I. D. N 8° E 12 links
 and a White Oak 6 I. D. S 49° W 12 links. Thence S 89° W
 20. 62 chain to a Bl. Oak 8 I. D. N 46° E 14 links with West
 line of the section. Thence with said line N 8° E 20 chain
 crossing a Lake to the beginning. Containing 81 ^{3/4} acres.

David Gwynne
 C. Sur. S. & O.

No. 951

(8435)

Survey Sept. 25 1841 for Robt. Gabbo part of Maitland
 Survey No. 950 as follows. Beginning at the SW corner
 of the Survey, the original corner tree all down, and
 from which a Hickory 10 In. Diameter bears N 20° W 22
 links distant. Thence N 78° E 234 poles to a Stone
 small hickory. Ash & Ironwood; Thence N 10° W 86
 poles to two Ironwood, from one west of Black Oak -
 Thence S 79° W 116 poles to a large White Oak; Thence
 S 11° E 22 poles to 2 White Oak; Thence S 78° W 119 poles to a
 Stake in a Prairie, in the Waterly line of the Survey; Thence
 with said line S 72° E 64 1/2 poles crossing a C. Road to the
 beginning Containing 110 ^{4/4} acres.

Robert G. Hopkins
 C. S. & O.