


106 to John Hills land, part of Jepson Davis's Survey N 94 E 77
thence with Hills north line S 70 W 26 poles to a small black
walnut and white oak; thence S 20 E 18 poles to a small
black oak white oak and Hickory. Thence S 70 W, crossing a
road at 100 poles) 101 poles to 2 bur oaks and jack oak; thence
S 20 W 63 poles to a stake
thence S 70 E crossing a road
at 84 poles (80 poles to a small
Hickory; thence N 20 W 10.3 poles
to a white oak thence N 70 E 47 to a white oak in Rob-
ert Smith's east line; thence with said line N 20 E 54 1/2
poles to the beginning part of Jepson Davis Survey N 94 E 77
Geo. Roots } Ja M. Harmon C. S. L. Co.
fr. Stewart } 66

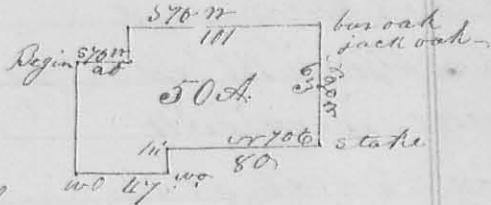

8240

3rd March, 12th 1830


Surveyor 127

Surveyed the 16 gr of sec. 31 S. 4 E. K. M. R. P. for
Patrick Moore beginning at a stake at the corner of
sec. 25, 26, 31 & 32 in said R. P. which stake bears N 70 E from a white oak 18 inch
diam., S 45 W 13 L. a white oak S 39 W 31 L. dist. thence
west (in easterly direction allowed) coming to a pond at 96 poles
170 poles to a stake in a cornfield thence N 70 E 15 poles to a
white oak 16 inches in diam.

in the north line of the sec.

thence with the original line
between sec 31 & 32 170 poles
to the beginning containing
166 1/4 acres -

Samuel Moore 3⁶⁶
William Craverton

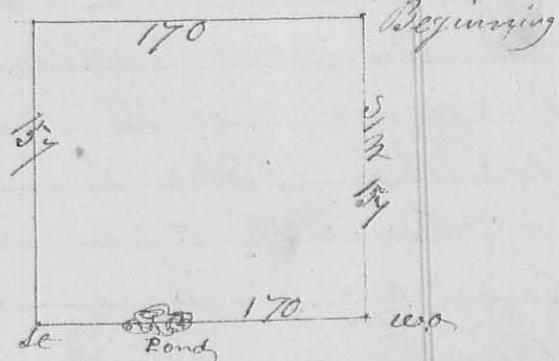

Ja M. Harmon C. S. L. Co.

8241

Article of Agreement Surveyor 128

This article of agreement made this 25th day of
March A.D. 1830 by us the undersigned citizens and
proprietors of the town of West Liberty, Logan
County, Ohio, witnesseth, that we each and everyone