


N^o 372

8426

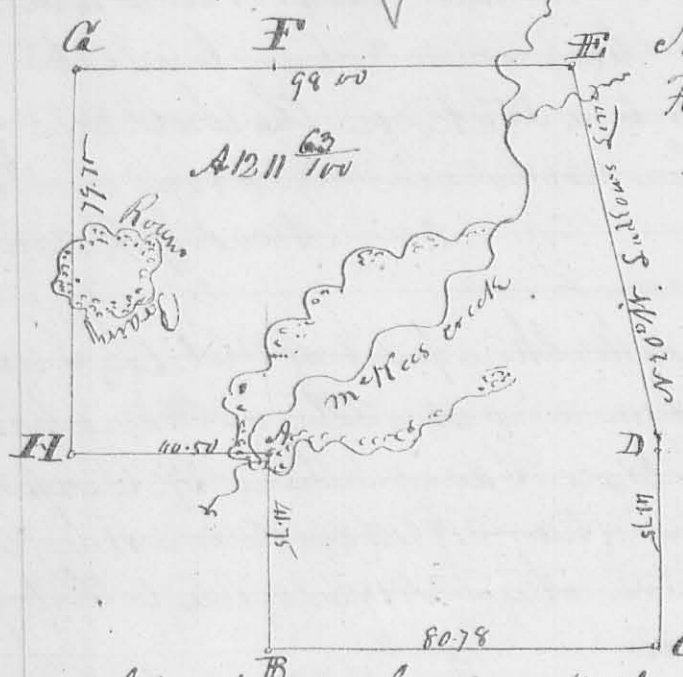

This plot represents the North half of S25. T4R16WRS. Front-Sub-26. & East half of S32. Same town and range. run at true Meridian - Present variation 40° E. " Sudden line 1° E. making its present bearing N 19° W.

Description of Corners.

- B. White Oak North 48 Sinks. Hickory 12 L.D. S 41 N 3.4 Sinks
- C Hickory 8 L.D. S 46 W 15 Sinks. and Hickory 12 L.D. N 57 E 48 Sinks
- D Stump. N.E. Corner of S25. the original bearing tree down
- E. N.E. Corner of S26. a White Oak S 46 N 22 Sinks. the other tree down
- F N.W. Corner of S26. A N.E. Corner to Bark heart of A.C. Stump
- H. White Oak 18 L.D. N 12 W 31 Sinks. and White Oak S 20 E 34 Sinks

John W. Colvin

John B. Miller } ch. Cor.

Dea. A. of Kim Co. Vir. I. C. &

N^o 373

8398

Various parts of Metitam Survey N^o 998. W. for Gray. Beginning at Sugar & Buck Exp. (into down Str Corn) to a Stake then S 12 E 114 poles to a buck marked RR RR then with the meander of Johnsons Mill Race S 85 W 22 1/2 poles to a stake. then S 14 W 11 1/2 poles to a stump then S 43 N 36 poles to a sugar. then S 53 3/4 W 10. 3/4 poles to a White Walnut. then S 75 W 19 poles to a Buck Exp. then N 82 W 13 1/2 poles to a Buck Exp. then N 68 W 7. 6/10 poles to a stake N 68 W 22 1/2 poles from a black Walnut then N 12 W 139 5/10 poles. Crops Creek at 2 poles to the beginning 80 acres. more or less. (no calculation has made also for J. S. Linsen. Beginning at the Buck marked RR as above