


8739

The 2^d tract Begins at a Stake on Elm
 N 12° 10' 19 links distant Blue Ash & Ironwood
 S.W. cor. to the above mentioned tract: thence N 65° 0'
 12 poles to a Stake: thence N 82° 10' 22 1/2 poles to a
 Blue Ash & Hickory (the Ash is down) S.W. cor. to
 R. Blakely: thence with his South line N 81° E 148
 poles crossing a Branch at 32 poles and small Branch or
 drain to 3^d Beech his S.E. cor.: thence S 38° E 25 poles
 to a Beech Elm & 2 Spruce (one down): thence S 57° W
 288 Poles crossing several branches to a Stone in a township
 road cor. to S. Lukins: thence with his East N 23° 10' 112
 Poles, to the Beginning containing 134 1/2 Acres
 C. Mechem C.S.L. Co

8477

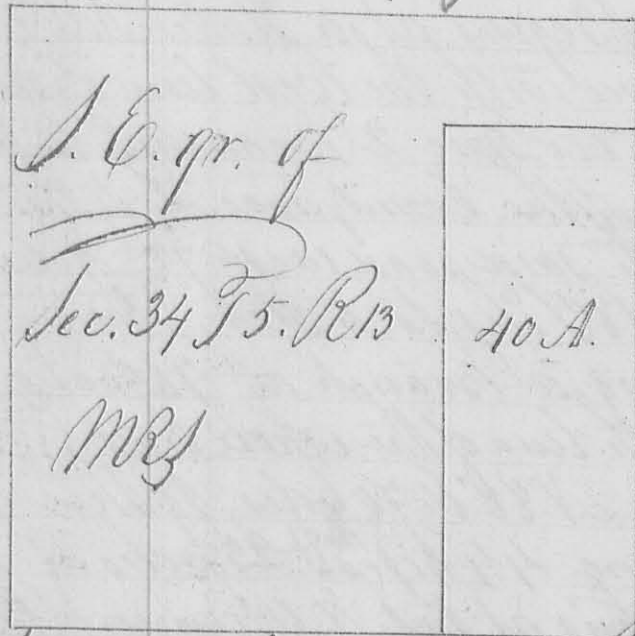

3^d Mo. March 3^d 1842
 Surveyed for Henry Tutten 40 acres of
 land being Part of the S.E. qr. of
 Sec 34 T. 5. R. 13 MRS: Beginning
 at the S.E. corner of said quarter
 Section: thence with the Section line
 N 1° E 129 3/10 Poles to a Stake Hickory 14
 in diameter N 21° E 10 links: thence
 N 89° 10' 48 7/10 poles to a Stake:
 thence S 1° 53' West 129 3/10 poles
 to a Stake in the South line
 of said quarter section:
 thence S 89° E 56 7/10 Poles to the Beginning

Survey N. 290

Survey N. 291

also
 Surveyed for Robert James Shiddy 2 1/10 acres
 being part of the S.E. Quarter of Sec. 34 T. 5. R. 13
 MRS: Beg. at a Stone in the East line of said quar-
 ter Section S.E. cor. to Mr. M. Betty thence with his South
 line N 88° W 26 1/2 Poles to the West Liberty Road: thence with
 said road S 42° E 42 Poles to a Stake in the East line of
 said qr. Section: thence with said east line N 1° E 32 Poles to
 the beginning containing 2 A. 2 R. 24 P. C. Mechem C.S.L. Co